

LABOR AND MATERIALS

Copper	} Connection _____	\$ _____	
Lead			
Curb	} Cock Valve } _____ in.	\$ _____	
		} T. S. & V. }	
Service box	} Short 3½ x 4½ }	\$ _____	
Old returned		Long 4½ x 5½ }	\$ _____
Ft. 3/4 in.	} Copper } Pipe at _____	\$ _____	
		} C.I. }	
Nipples	in. at _____	\$ _____	
Bushings	to _____ in. at _____	\$ _____	
Red'g	} Coupl'gs. _____ to _____ in. at _____	\$ _____	
Inc'g			
Union	in. at _____	\$ _____	
Meter	in. at _____	\$ _____	
Compound Joints	at _____	\$ _____	
Maintenance Foreman		\$ _____	
Hrs. Water Maint. Man—1	at _____	\$ _____	
Hrs. Water Maint. Man—2	at _____	\$ _____	
Hrs. Garage Foreman	at _____	\$ _____	
Hrs. Labor	at _____	\$ _____	
Hrs. Compressor	at _____	\$ _____	
Trucking		\$ _____	
Pav't Patch		\$ _____	
		\$ _____	
		\$ _____	
		\$ _____	
		\$ _____	


DOUGLAS

St. Pt. Ave. No. 18

Name of Owner \_\_\_\_\_

Labor and Mat'l. Report

19 91

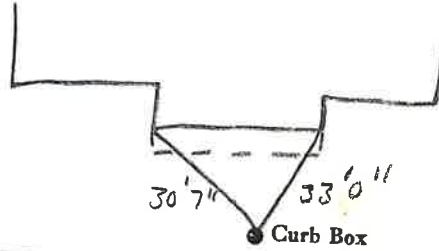

12" Main

Elev. of Main at tap \_\_\_\_\_

Gate at ●

● Gate at \_\_\_\_\_

● Curb Box

RENEWAL TAP