

LABOR AND MATERIALS

1	Copper	Connection	$\frac{3}{4}$	\$	
1	Curb	Cock Valve T.S. & V.	$\frac{3}{4}$ in.	\$	
1	Service box Old returned	Short $3\frac{1}{2} \times 4\frac{1}{2}$ Long $4\frac{1}{2} \times 5\frac{1}{2}$	$\frac{3}{4}$	\$	
10	Ft.	$\frac{3}{4}$ in. { Copper Gal. C.I. }	Pipe at	\$	
	Nipples	in. at		\$	
	Bushings	to in. at		\$	
	Red'g Inc'g	Coupl'gs to in. at		\$	
	Union	in. at		\$	
	Meter	in. at		\$	
	Compound Joints	at		\$	
	Maintenance Foreman			\$	
	Hrs. Water Maint. Man-1	at		\$	
	Hrs. Water Maint. Man-2	at		\$	
	Hrs. Garage Foreman	at		\$	
	Hrs. Labor	at		\$	
	Hrs. Compressor	at		\$	
	Trucking			\$	
	Pav't Patch			\$	
				\$	
				\$	

DOUGLAS

Ave. No. 19

Name of Owner

Labor and Mat'l. Report

JUNE 7 19 28

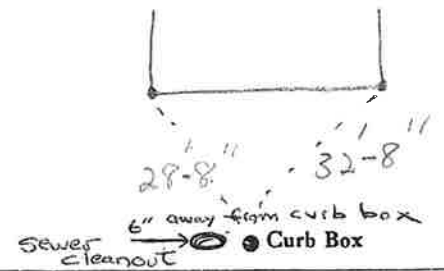

12" Main

Elev. of Main at tap $4\frac{1}{2}$

Gate at ●

● Gate at

● Curb Box

NEW HOUSE