

LABOR AND MATERIALS

1 Copper Lead	Connection	$\frac{3}{4}$			\$ 1.35	
1 Curb	Cock Valve	$\frac{3}{4}$	in.		\$ 1.88	
1 Service Box Old returned	}	Short	$3\frac{1}{2} \times 4\frac{1}{2}$	}	\$ 1.82	
		Long	$4\frac{1}{2} \times 5\frac{1}{2}$			
		Buff. or Rdway				
25 Ft. $\frac{3}{4}$ in.				Pipe at 20	\$ 5.00	
Nipples	in.				\$	
Bushings	to		in.		\$	
Red'g Inc'g	Couplings		to		in.	\$
Union		in.			\$	
Meter	in.				\$	
Lead Joints					\$	
Leadite Joints					\$	
Hrs. Foreman					\$	
1 Hrs. Chauffeur		.6834			\$.69	
1 Hrs. Tapper					\$	
6 Hrs. Labor		.55			\$ 3.30	
Hrs. Labor					\$	
Hrs. Compressor					\$	
Compensation Ins.					\$.13	
Trucking					\$ 1.00	
Builders Use of Water	Patch (Sever)				\$ 2.50	
Tap by Miller						
\$ 17.67						

H.

26 1942


St. 22
Pl. 16
Ave. No. 16

Douglas

Name of Owner

Hosbaway

Labor and Mat'l. Report June 10 1942

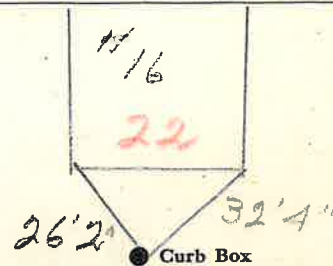

12" Main Elev. of Main at tap 5

Gate at ● ● Gate at

● Curb Box

H.