

LABOR AND MATERIALS

1. Copper Lead Connection $\frac{3}{4}$	\$ 2.87
1. Curb { Cock Valve T. S. & V. } $\frac{3}{4}$ in.....	\$ 3.62
1. Service box { Short $3\frac{1}{2} \times 4\frac{1}{2}$ } Old returned { Long $4\frac{1}{2} \times 5\frac{1}{2}$ } { Buff or Rdway }	\$ 4.68
5. Ft. $\frac{3}{4}$ in. { Copper } Pipe at 32	\$ 1.60
{ G. I. }	
{ C. I. }	
..... Nipples..... in. at.....	\$.....
..... Bushings..... to..... in. at.....	\$.....
..... Red'g Inc'g Coupl'gs..... to..... in. at.....	\$.....
..... Union..... in. at.....	\$.....
..... Meter..... in. at.....	\$.....
..... Lead Joints at.....	\$.....
..... Compound Joints at.....	\$.....
..... Hrs. Water Maint. Man—1 at.....	\$.....
2. Hrs. Water Maint. Man—2 at 1.02	\$ 2.04
2. Hrs. Labor—..... at 91	\$ 1.82
..... Hrs. Labor—..... at.....	\$.....
..... Hrs. Compressor at.....	\$.....
..... Compensation Ins. at \$2.18 per C.....	\$ 4.08
..... Trucking.....	\$ 2.00
..... Pav't Patch.....	\$ 10.25
<i>Tap by Manson'slee</i>	
.....	\$.....
.....	\$.....
.....	\$.....
..... O'head.....	\$.....
	\$28.96

22

SE
PI
Ave. No. 23

Douglas


Name of Owner

Minor

Labor and Mat'l. Report

May 4

1949

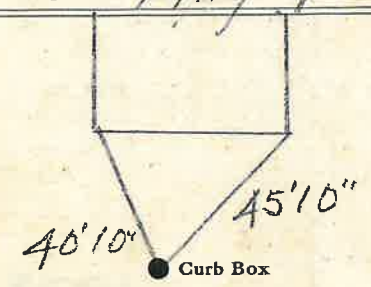

12" Main

Elev. of Main at tap 5-1

Gate at ●

● Gate at

● Curb Box