

LABOR AND MATERIALS

/ Copper } Connection $\frac{3}{4}$		\$ 1.78	
Lead }			
/ Curb { Clock Valve T. S. & V. } $\frac{3}{4}$ in.		\$ 2.61	
/ Service box Old returned { Short $3\frac{1}{2} \times 4\frac{1}{2}$ Long $4\frac{1}{2} \times 5\frac{1}{2}$ Buff or Rdway }		\$ 1.82	
25 Ft. $\frac{3}{4}$ in. { Copper Galv. Iron Cast Iron }	Pipe at 23	\$ 5.95	
..... Nipples	in. at	\$	
..... Bushings	to	in. at	\$
..... Red'g Inc'g } Couplings	to	in. at	\$
..... Union	in. at	\$	
..... Meter	in. at	\$	
..... Lead Joints at		\$	
..... Compound Joints at		\$	
1 Hrs. Foreman at W.C.M.	84	\$ 84	
4 Hrs. Chauffeur at	75	\$ 300	
6 Hrs. Tapper at		\$ 450	
14 Hrs. Labor at	65	\$ 910	
Hrs. Labor at		\$	
Hrs. Compressor at		\$	
..... Compensation Ins.		\$.48	
..... Trucking		\$ 1.00	
..... Builders Use of Water		\$ 5.00	
Tap by McGuinn			
<hr/>			
\$ 35.88			

27-46

St. 24
Plv. 18
Ave. No. 18


Douglass

Name of Owner

Burns

Labor and Mat'l. Report

May 17 1946

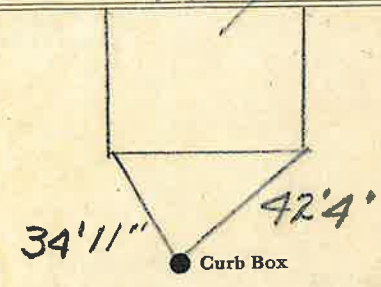

\times 12" Main

Elev. of Main at tap $5\frac{1}{2}$

Gate at ● Gate at ●

● Curb Box