

LABOR AND MATERIALS

Copper	}	Connection		\$		
Lead						
Curb	}	Cock	in.	\$		
		Valve				
		T. S. & V.				
Service box	}	Short 3½ x 4½	}	\$		
Old returned		Long 4½ x 5½				
		Buff or Rdway				
24 Ft. 3/4 in.	}	Copper	}	\$	Pipe at	
		G. I.				
		G. I.				
Nipples	in.	at		\$		
Bushings	to	in.	at	\$		
Red'g	}	Coupl'gs	to	in.	at	\$
Inc'g						
Union	in.	at		\$		
Meter	in.	at		\$		
Lead Joints	at			\$		
Compound Joints	at			\$		
Maintenance Foreman				\$		
Hrs. Water Maint. Man-1	at			\$		
Hrs. Water Maint. Man-2	at			\$		
Hrs. Garage Foreman	at			\$		
Hrs. Labor	at			\$		
Hrs. Compressor	at			\$		
Compensation Ins. at \$		per C		\$		
Trucking				\$		
Pav't Patch				\$		
				\$		
				\$		
O'head				\$		
				\$		

St. _____
 Pl. _____
 Ave. No. 8-10


Douglas

Name of Owner

Keysey

Labor and Mat'l. Report

1986

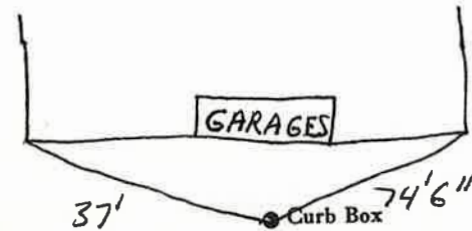

12" Main

Elev. of Main at tap

Gate at ●

● Gate at

AX ID # 302.12-3-15

● Curb Box