

LABOR AND MATERIALS


1	Copper	} Connection $3/4"$	\$ 2.71
	Lead		
1	Curb	} $5/4"$ in.	\$ 3.83
	<del>Valve</del> T.S. & V.		
1	Service box	{ Short $3\frac{1}{2} \times 4\frac{1}{2}$ Long $4\frac{1}{2} \times 5\frac{1}{2}$ Buff. or Rdway.	\$ 4.69
	Old returned		
8	Ft. $3/4"$ in.	{ Copper G.I. C.I. } Pipe at $45$	\$ 3.60
	Nipples	in. at	\$
	Bushings	to in. at	\$
	Red'g	} Coupl'gs. to in. at	\$
	Inc'g		
	Union	in. at	\$
	Meter	in. at	\$
	Lead Joints at		\$
	Compound Joints at		\$
	Maintenance Foreman		\$
	Hrs. Water Maint. Man—1 at		\$
4	Hrs. Water Maint. Man—2 at	$1.24$	\$ 9.92
	Hrs. Garage Foreman at		\$
16	Hrs. Labor— at	$1.13$	\$ 18.08
	Hrs. Compressor at		\$
	Compensation Ins. at \$ $4.29$ per C		\$ 1.20
	Trucking		\$ 1.50
	Pay't Patch		\$ 6.75
	Tap by <i>J. S. G. Ford</i>		\$
	$7-5-55$		\$
	O'head		\$
			\$ 52.28

45.53

~~St.~~  
~~Pl.~~  
*Douglas* Ave. No. *11*

Name of Owner  
*R. M. Peddie*

Labor and Mat'l. Report *July 5* 19*55*

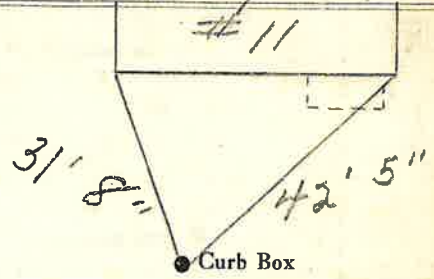

$12"$  Main Elev. of Main at tap  $4\frac{1}{2}"$

Gate at • Gate at

• Curb Box

476