


# LABOR AND MATERIALS

1 <del>Lead</del> } Copper Connection $\frac{3}{4}$ \$
1 Curb } Cock Valve } $\frac{3}{4}$ in. \$
1 Service box } Old returned } { Short $3\frac{1}{2} \times 4\frac{1}{2}$ Long $4\frac{1}{2} \times 5\frac{1}{2}$ Buff or Rdway } \$
27 Ft. $\frac{3}{4}$ in. } { Copper } Pipe at \$
} G.I. }
} C.I. }
Nipples _____ in. at \$
Bushings _____ to _____ in. at \$
Red'g } Coupl'gs _____ to _____ in. at \$
Ino'g }
Union _____ in. at \$
Meter _____ in. at \$
Lead Joints at \$
Compound Joints at \$
Maintenance Foreman \$
Hrs. Water Maint. Man—1 at \$
Hrs. Water Maint. Man—2 at \$
Hrs. Garage Foreman _____ at \$
Hrs. Labor _____ at \$
Hrs. Compressor at \$
Compensation Ins. at \$ _____ per C. \$
Trucking _____ \$
Pav't Patch _____ \$
Taps July 3, 1979 \$
H. H. & C. \$
O'head _____ \$
_____ \$
_____ \$

Douglas St. Ave. No. 12  
Name of Owner

Hollis Ackley

Labor and Mat'l. Report July 3 1979

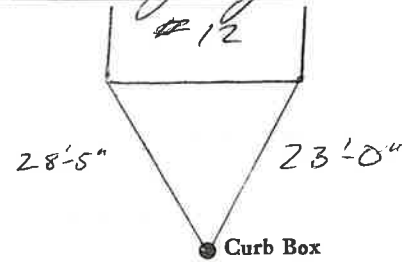

12" Main Elev. of Main at tap 5'

Gate at ● ● Gate at

● Curb Box