


# LABOR AND MATERIALS

_____ Copper } Connection _____ \$ _____	
_____ Lead } _____	
_____ Curb } Cock } _____ in. _____ \$ _____	
_____ } Valve } _____	
_____ } T.S. & V. } _____	
_____ Service box { Short 3-1/2 x 4-1/2 } _____ \$ _____	
_____ Old returned { Long 4-1/2 x 5-1/2 } _____	
_____ Ft. _____ in. { Copper } Pipe at _____ \$ _____	
_____ } G.I. } _____	
_____ } C.I. } _____	
_____ Nipples _____ in. at _____ \$ _____	
_____ Bushings _____ to _____ in. at _____ \$ _____	
_____ Red'g _____	
_____ Inc'g _____	
_____ Union _____ in. at _____ \$ _____	
_____ Meter _____ in. at _____ \$ _____	
_____ _____ \$ _____	
_____ Compound Joints at _____ \$ _____	
_____ Maintenance Foreman _____ \$ _____	
_____ Hrs. Water Maint. Man - 1 at _____ \$ _____	
_____ Hrs. Water Maint. Man - 2 at _____ \$ _____	
_____ Hrs. Garage Foreman _____ at _____ \$ _____	
_____ Hrs. Labor _____ at _____ \$ _____	
_____ Hrs. Compressor at _____ \$ _____	
_____ _____ \$ _____	
_____ Trucking _____ \$ _____	
_____ Pav't Patch _____ \$ _____	
_____ _____ \$ _____	
_____ _____ \$ _____	
St. \_\_\_\_\_  
 Pt. \_\_\_\_\_  
 Ave. No. \_\_\_\_\_

Name of Owner  
14 DOUGLAS AVE

Labor and Mat'l. Report 19

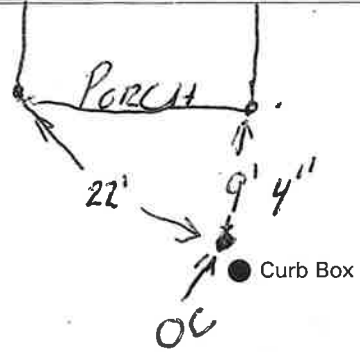

\_\_\_\_\_ Main Elev. of Main at tap \_\_\_\_\_

Gate at ● Gate at ●

● Curb Box

# LABOR AND MATERIALS

1	Copper Lead	Connection	3/4"		\$
1	Curb	Cock Valve T.S. & V.	3/4 in. Orisetal		\$
1	Service box Old returned	Short 3 1/2 x 4 1/2 Long 4 1/2 x 5 1/2 Buff or Rdway			\$
31	Ft. 3/4 in.	Copper C.I. C.I.	Pipe at		\$
	Nipples	in. at			\$
	Bushings	to in. at			\$
	Red'g Inc'g	Coupl'gs	to in. at		\$
	Union	in. at			\$
	Meter	in. at			\$
	Lead Joints	at			\$
	Compound Joints	at			\$
	Maintenance Foreman				\$
	Hrs. Water Maint. Man-1	at			\$
	Hrs. Water Maint. Man-2	at			\$
	Hrs. Garage Foreman	at			\$
	Hrs. Labor	at			\$
	Hrs. Compressor	at			\$
	Compensation Ins.	at \$	per C		\$
	Trucking				\$
	Pav't Patch				\$
	Tap made by Gifford & Co.				\$
	12-1-64				\$
	O'head				\$
					\$

St. \_\_\_\_\_  
Pl. \_\_\_\_\_  
Ave. No. 14

Douglas

Name of Owner  
Robt. La May

Labor and Mat'l. Report Dec. 1 1964

