


LABOR AND MATERIALS

1 Copper } Connection _____ \$
~~Lead~~ }
 1 Curb } Cock _____ in. \$
 } Valve _____ }
 } P.S. 2 1/2" }
 1 Service box { Short 3 1/2 x 4 1/2 }
 Old returned { Long 4 1/2 x 5 1/2 } _____ \$
 25 Ft. 3/4 in. { Copper } Pipe at _____ \$
 } C.I. }
 } C.I. }
 Nipples in. at _____ \$
 Bushings to in. at _____ \$
 1 Red } Coupl'gs to in. at _____ \$
 1/2" }
 Union in. at _____ \$
 Meter in. at _____ \$
 _____ \$
 Compound Joints at _____ \$
 Maintenance Foreman _____ \$
 Hrs. Water Maint. Man-1 at _____ \$
 Hrs. Water Maint. Man-2 at _____ \$
 Hrs. Garage Foreman at _____ \$
 Hrs. Labor at _____ \$
 Hrs. Compressor at _____ \$
 _____ \$
 Trucking _____ \$
 Pav't Patch _____ \$
 _____ \$
 _____ \$
DUDLEY St. ~~St.~~
 Ave. No. 9

Name of Owner
 TAX ID # 309.15-10-9

Labor and Mat'l. Report DEC. 18 1925

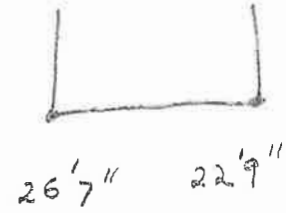

● Curb Box

4" Main Elev. of Main at tap 5'
 Gate at ● Gate at ●

● Curb Box