


LABOR AND MATERIALS

1	Copper	Connection	1	\$
1	Lead			\$
1	Curb	Cock Valve T.S. & V.	$\frac{3}{4}$ in.	\$
1	Service box	Short $3\frac{1}{2} \times 4\frac{1}{2}$		\$
	Old returned	Long $4\frac{1}{2} \times 5\frac{1}{2}$		\$
10	Ft.	Copper G.I. G.I.	Pipe at	\$
1	Nipples	$1\frac{1}{4}$ in.	at	\$
	Bushings	to in.	at	\$
1	Redg. Inc's	Coupl'gs.	$1\frac{1}{4}$ to $\frac{3}{4}$ in.	\$
	Union	in.	at	\$
	Meter	in.	at	\$
	Compound Joints	at		\$
	Maintenance Foreman			\$
	Hrs. Water Maint. Man	1 at		\$
	Hrs. Water Maint. Man	2 at		\$
	Hrs. Garage Foreman	at		\$
	Hrs. Labor	at		\$
	Hrs. Compressor	at		\$
	Trucking			\$
	Pav't Patch			\$
				\$
				\$
				\$
				\$

EAST
 S.E. Pk. Ave. No. 2
 Name of Owner

Labor and Mat'l. Report OCT. 27 1925

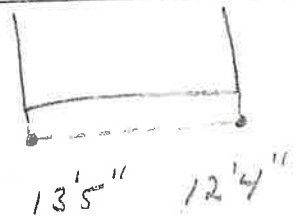

● Curb Box

$1\frac{1}{4}$ Main Elev. of Main at tap 4'
 Gate at ● Gate at

● Curb Box

33 LENGTHS $1\frac{1}{4}$ " PIPE
 1 - RED. $1\frac{1}{4}$ " X $\frac{3}{4}$ "
 1 - $1\frac{1}{4}$ " NIP