

LABOR AND MATERIALS


1	Copper Lead	Connection	\$
1	Curb	Cock Valve T.S. & V. } in.	\$
	Service box Old returned	{ Short 3 1/2 x 4 1/2 } { Long 4 1/2 x 5 1/2 }	\$
10	Ft. 3/4 in.	{ Copper } { G. I. } { C.I. }	Pipe at \$
	Nipples	in. at	\$
	Bushings	to in. at	\$
	Red'g Inc'g }	Coupl'gs to in. at	\$
	Union	in. at	\$
	Meter	in. at	\$
	Compound Joints	at	\$
	Maintenance Foreman		\$
	Hrs. Water Maint. Man-1	at	\$
	Hrs. Water Maint. Man-2	at	\$
	Hrs. Garage Foreman	at	\$
	Hrs. Labor	at	\$
	Hrs. Compressor	at	\$
	Trucking		\$
	Pav't Patch		\$
			\$
			\$
ELM

St. Pt. Ave. No. 21

Name of Owner  
FERRIS - BOSTON CANDY

Labor and Mat'l. Report MAY 9-10 19 23

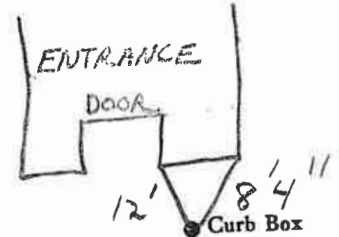

6" Main

Elev. of Main at tap 5'

Gate at • Gate at

TAX ID # 302.20-28-23

• Curb Box

ORISEAL BOX  
MEASURED 2000