

LABOR AND MATERIALS

1	Copper	{ Connection	3/4	\$	2.29
	Lead				
1	Curb	{ Cock Valve	3/4 in.	\$	2.70
		T.S. & V.			
	Service box	{ Short 3 1/2 x 4 1/2	} Same	\$	—
	Old returned	Long 4 1/2 x 5 1/2			
23	Ft.	{ Copper	} Pipe at 35	\$	8.05
	3/4 in.	G.I.			
		C.I.			
	Nipples	in. at		\$	
	Bushings	to in. at		\$	
	Red'g	{ Coupl'gs	to in. at	\$	
	Inc'g				
	Union	in. at		\$	
	Meter	in. at		\$	
	Lead Joints at			\$	
	Compound Joints at			\$	
1	Hrs. Water Maint. Man-1	at	112	\$	1.12
9	Hrs. Water Maint. Man-2	at	102	\$	9.18
21	Hrs. Labor	at	91	\$	19.11
	Hrs. Labor	at		\$	
2	Hrs. Compressor at		120	\$	2.40
	Compensation Ins. at \$2.226 per C.			\$	65
	Trucking			\$	1.00
	Pav't Patch			\$	10.08
	Tap by Warsaw Sec			\$	
	O'head			\$	
				\$	56.58


2-1950

St.
~~Pl.~~
Ave. No. 24

Elm

Name of Owner Nathan Proffer
Chester INS.

Labor and Mat'l. Report Dec 6 1949

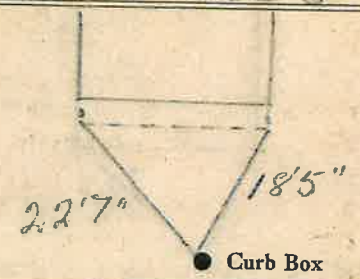

6" Main

Elev. of Main at tap 5 1/2'

Gate at ● ● Gate at

● Curb Box