

LABOR AND MATERIALS


1	Copper Lead	Connection	1"	\$ 2.14
1	Curb	Cock Valve T.S. & V.	1" in.	\$ 2.61
1	Service Box	Short 3 1/2 x 4 1/2		
	Old returned	Long 4 1/2 x 5 1/2		\$ 1.60
		Buff. or Rdway		
25 Ft.	1" in.	Copper Galv Iron Cast Iron	Pipe at	22 \$ 5.50
	Nipples	in. at		\$
	Bushings	to in. at		\$
	Red'g Inc'g	Couplings to in. at		\$
	Union	in. at		\$
	Meter	in. at		\$
	Lead Joints	at		\$
	Leadite Joints	at		\$
	Hrs. Foreman	at		\$
7	Hrs. Chauffeur	at	6 1/2	\$ 4.38
2 1/2	Hrs. Tapper	at		\$ 1.56
2 1/2	Hrs. Labor	at	45	\$ 9.90
	Hrs. Labor	at		\$
	Hrs. Compressor	at		\$
	Compensation Ins.			\$ 49
	Trucking			\$ 1.00
	Builders Use of Water	no patch		\$
	TAP by Miller			\$
				\$
				\$
				\$
				\$
				\$ 27.49

6 8 - - 1940

St. Pl. Ave. No. 34-

FLIM Name of Owner Mac Naughton Hughes 36

Labor and Mat'l. Report July 5 1940

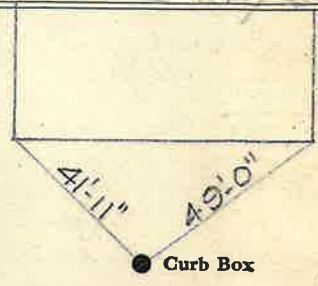

6 Main Elev. of Main at tap

Gate at Gate at

Probably
holed on
part of La Pointe
- 45 SOUTH ST

Domestic Service.
1" TAP

LABOR AND MATERIALS

Copper	} Connection		\$	
Lead				
1 Curb	} 6" TAPPING GATE & SLEEVE			
		Cock Valve	in.	\$
		T. S. & V.		
1 Service box	} GATE BOX	Short 3 1/2 x 4 1/2		
Old returned		Long 4 1/2 x 5 1/2		
		Buff or Rdway		
27 Ft. 6" in.	} Pipe at	Copper	\$	
		G. I.		
		G. I.		
Nipples	in. at		\$	
Bushings	to in. at		\$	
Red'g	} Coupl'gs. to in. at		\$	
Inc'g				
Union	in. at		\$	
Meter	in. at		\$	
Lead Joints	at		\$	
Compound Joints	at		\$	
Maintenance Foreman			\$	
Hrs. Water Maint. Man-1	at		\$	
Hrs. Water Maint. Man-2	at		\$	
Hrs. Garage Foreman	at		\$	
Hrs. Labor	at		\$	
Hrs. Compressor	at		\$	
Compensation Ins. at \$	per C.		\$	
Trucking			\$	
Pav't Patch			\$	
BY Gifford.			\$	
			\$	
			\$	
O'head			\$	
			\$	

SPRINKLER SYSTEM

ELM


St. 34
Fl. 34
Ave. No. 36

Name of Owner

Dress Factory

Measured IN

Labor and Mat'l. Report Feb. 17-19 56

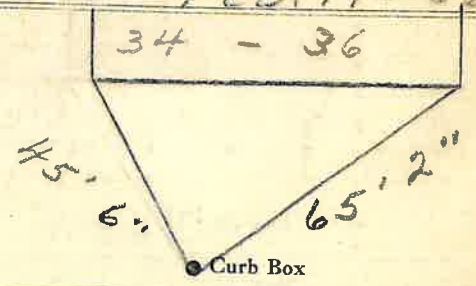

6" Main

Elev. of Main at tap 5'

Gate at ●

● Gate at

● Curb Box

6" Tap.

TAP MADE 8-9-21