

LABOR AND MATERIALS

/ Copper { Connection $\frac{3}{4}$ } \$ 1.31
 / Lead { }
 / Curb { Cock Valve } $\frac{3}{4}$ in. \$ 1.75
 { T. S. & V. }
 / Service Box { Short $3\frac{1}{2} \times 4\frac{1}{2}$ } BRISCAL \$ 1.60
 Old returned { Long $4\frac{1}{2} \times 5\frac{1}{2}$ }
 { Buff. or Rdway }
 8 Ft. $\frac{3}{4}$ in. { Copper } Pipe at 18 \$ 1.44
 { Galv Iron }
 { Cast Iron }
 Nipples in. at \$
 Bushings to in. at \$
 Red'g } Couplings to in. at \$
 Inc'g }
 Union in. at \$
 Meter in. at \$
 Lead Joints at \$
 Leadite Joints at \$
 Hrs. Foreman at \$
 2 Hrs. Chauffeur at $6 \times \frac{1}{2}$ \$ 1.25
 1 Hrs. Tapper at $\frac{1}{2}$ \$.62
 7 Hrs. Labor at 45 \$ 3.15
 Hrs. Labor at \$
 Hrs. Compressor at \$
 Compensation Ins. \$ 16
 Trucking \$ 1-
 Builders Use of Water $\frac{1}{2}$ patch \$
 Tap by Miller $\frac{1}{2}$ for Parry \$
 \$
 \$
 \$
 \$ 12.28


6 9 - - 1940

St. 37
Pl. 37
Ave. No. 37

Name of Owner

Labor and Mat'l. Report

19

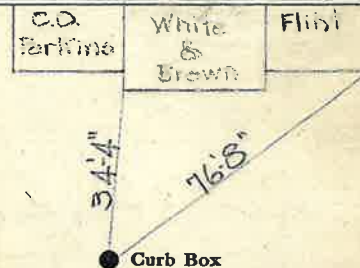

Main

Elev. of Main at tap

Gate at ●

● Gate at

PROBABLY

RAZED on parts
 of Sandy's -
 41 SOUTH ST