

### LABOR AND MATERIALS

1	Copper	Connection	3/4		\$ 1.31
	Lead				
1	Curb	Cock Valve	3/4	in.	\$ 1.75
		T. S. & V.			
1	Service Box	Short 3/4x4 1/2			
	Old returned	Long 4 1/2x5 1/2			\$ 1.60
		Buff. or Rdway			
8	Ft.	3/4 in.		Pipe at 18	\$ 1.44
	Nipples	in. at			\$
	Bushings	to in. at			\$
	Red'g	Couplings			
	Inc'g		to in. at		\$
	Union	in. at			\$
	Meter	in. at			\$
	Lead Joints	at			\$
	Leadite Joints	at			\$
	Hrs. Foreman	at			\$
2	Hrs. Chauffeur	at	62 1/2		\$ 1.25
1	Hrs. Tapper	at	v		\$ .62
7	Hrs. Labor	at	45		\$ 3.15
	Hrs. Labor	at			\$
	Hrs. Compressor	at			\$
	Compensation Ins.				\$ 16
	Trucking				\$ 1.00
	Builders Use of Water				\$
	Tap by Miller				\$
					\$
					\$
					\$
					\$
					\$ 12.28

7 0 - - 1940

St.

Pt-


Ave. No. 27

Name of Owner

Lot tap Sherall

Labor and Mat'l. Report

1940

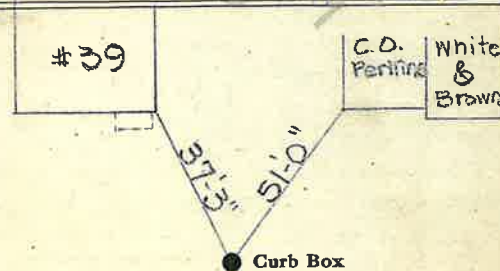

Main

Elev. of

Main at tap

Gate at

Gate at

● Curb Box

Sherall's Empty  
Lot tap. Now A+P  
Parking Lot.