

Labor and Materials

1	Copper } Connection	$\frac{3}{4}$	\$	3.20
	Lead			
1	Curb } Cock	$\frac{3}{4}$ in.	\$	1.00
	Valve			
	Service Box	Short 3 1/2 x 4	\$	1.30
	Old returned	1.00 x 6		
		Ball or Rdway		
23	Ft. $\frac{3}{4}$ in. Copper	Pipe at	\$	5.06
		Cast-iron		
	Nipples	in. at	\$	
	Bushings	to in. at	\$	
1	Red iron } Couplings	to in. at	\$	1.07
	Union	in. at	\$	
	Meter	in. at	\$	
	Lbs. Br. Stone	at	\$	
	Lbs. Sand	at	\$	
	Bags Cement	at	\$	
	Paving Brick	Mack Red Asphalt at	\$	
	Lead Joints	at	\$	
	Leadite Joints	at	\$	
2	Hrs. Foreman	at	\$	1.25
3	Hrs. Common Labor	at	\$	4.50
4	Hrs. Common Labor	at	\$	1.63
	Hrs. Mason	at	\$	
	Hrs. Mason's Helper	at	\$	
	Hrs. Compressor	at	\$	
	Compensation Ins.	at	\$	1.18
1	Trucking	at	\$	1.00
	Builders' Use of Water	at	\$	
			Total	\$ 6.99

27-156

Labor and Material Report SEPT 9 1927

38 ELM ST

Colonial Rest.

See below


● Curb Box

6" Main


Elev. of Main at tap 6'

Gate at ●

● Gate at

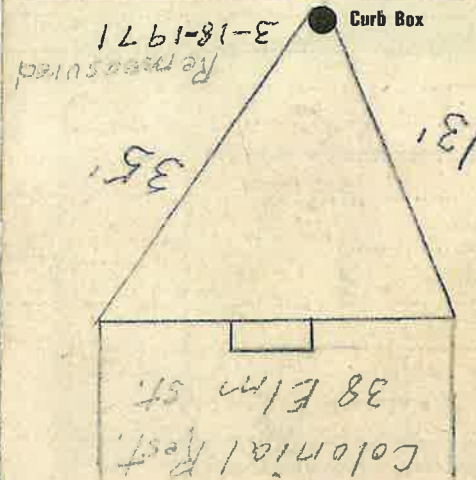

Colonial Rest.
38 Elm St.

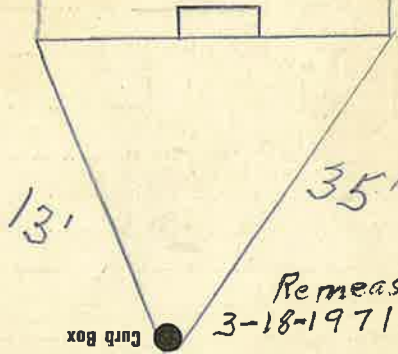

Gate at ● Gate at ●

Main Elev. of Main at tap 6" 6"

● Curb Box

See below
Colonial Rest.

38 ELM ST

Labor and Material Report SEPT 9 1927

27-158