

Labor and Materials

1	Copper } Connection		\$ 3.20
	Lead } "		
	Curb { Cock		
	{ Valve		\$ 1.50
	{ T. S. & V. }	in.	
1	Service Box } Short 3 1/2 x 4 1/2		\$ 1.30
	Old returned } Long 4 1/2 x 5 1/2		
		Buff. or Rdway	
10	Pt. 3/4 in. } Copper		\$ 2.20
	{ Galv. Iron		
	{ Cast Iron		
		Pipe at.	
	Nipples	in. at.	\$
	Bushings	to in. at.	\$
	Red'g } Couplings	to in. at.	\$
	Inc'g }		
	Union	in. at.	\$
	Meter	in. at.	\$
	Lbs. Br. Stone	at.	\$
	Lbs. Sand	at.	\$
	Bags Cement	at.	\$
	Paving Brick { Mack		
	{ Red		
	{ Asphalt }	at.	\$
	Lead Joints	at.	\$
	Leadite Joints	at.	\$
3	Hrs. Foreman	at.	\$ 1.87
7	Hrs. Common Labor	at.	\$ 3.50
70	Hrs. Common Labor	at.	\$ 4.00
	Hrs. Mason	at.	\$
	Hrs. Mason's Helper	at.	\$
	Hrs. Compressor	at.	\$
	Compensation Ins.		\$ 25
1	Trucking		\$ 1.00
	Builders' Use of Water		\$
	Total		\$ 18.38

27-134

Labor and Material Report Aug 11

19 27

no 39 Elm St




This
Curb box IN DRIVE way
of Parking lot
Main Elev. of Main at tap 5'

Gate at ●

● Gate at

● Curb Box

Copper connection shut off
at main. 11/22/50 because

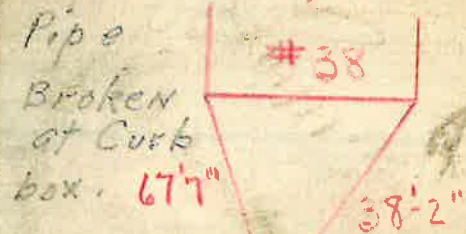

Pipe
Broken
at Curb
box. 67 7/8"

● Connection for #39