

LABOR AND MATERIALS

1	Copper Lead	Connection	3/4		\$ 1.31
1	Curb	Cock Valve F. S. & V.	3/4 in.		\$ 1.75
1	Service Box Old returned	Short 3 1/2 x 4 1/2 Long 4 1/2 x 5 1/2 Buff. or Rdway			\$ 1.60
29	Ft. 3/4 in.	Copper Galv. Iron Cast Iron	Pipe at 18		\$ 4.32
	Nipples	in. at			\$
	Bushings	to in. at			\$
	Red'g Inc'g	Couplings	to in. at		\$
	Union	in. at			\$
	Meter	in. at			\$
	Lead Joints	at			\$
	Leadite Joints	at			\$
	Hrs. Foreman	at			\$
6	Hrs. Chauffeur	at	6 2/10		\$ 3.75
2 1/2	Hrs. Tapper	at	"		\$ 1.56
22	Hrs. Labor	at	45		\$ 9.90
	Hrs. Labor	at			\$
	Hrs. Compressor	at			\$
	Compensation Ins.				\$ 47
	Trucking				\$ 1.00
	Builders Use of Water				\$
	Tap by Hassel				\$
					\$
					\$
					\$ 25.66

71 -- 1940

St.

Elm

Pl.


Ave. No. 40

Name of Owner

Scales

Labor and Mat'l. Report

July 19 1940

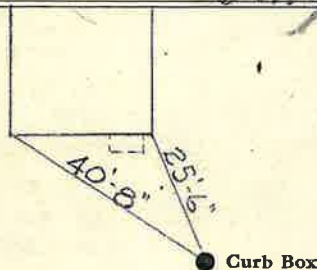

Main

Elev. of

Main at tap

Gate at

Gate at

● Curb Box

This house razed.

Shut off at Curb.

4-4-60.