


LABOR AND MATERIALS

Copper	} Connection	_____	\$ _____
Lead		_____	\$ _____
Curb	} Cock Valve T.S. & V.	_____ in.	\$ _____
		_____	\$ _____
1 Service box	} Short 3 1/2 x 4 1/2	_____	\$ _____
Old returned		Long 4 1/2 x 5 1/2	_____
25 Ft. 3/4 in.	} Copper	} Pipe at	\$ _____
			Gal.
Nipples	in. at	_____	\$ _____
Bushings	to in. at	_____	\$ _____
Red'g } Inc'g }	} Coupl'gs	to in. at	\$ _____
Union			in. at
Meter	in. at	_____	\$ _____
Compound Joints	at	_____	\$ _____
Maintenance Foreman		_____	\$ _____
Hrs. Water Maint. Man-1	at	_____	\$ _____
Hrs. Water Maint. Man-2	at	_____	\$ _____
Hrs. Garage Foreman	at	_____	\$ _____
Hrs. Labor	at	_____	\$ _____
Hrs. Compressor	at	_____	\$ _____
Trucking		_____	\$ _____
Pav't Patch		_____	\$ _____
		_____	\$ _____
		_____	\$ _____

St. ELM Ave. No. 46

Name of Owner \_\_\_\_\_

Labor and Mat'l. Report APR. 27 1936

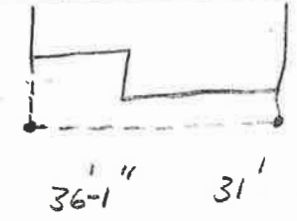

● Curb Box

6" Main Elev. of Main at tap 5'

Gate at ● Gate at ●

TAX ID # 309.28-1-18

● Curb Box

OLD TAP SHUT OFF  
OUTSIDE CLEANOUT LOCATED IN  
RIGHT HAND DRIVEWAY