


LABOR AND MATERIALS

1	Copper	} Connection $\frac{3}{4}$	\$
	Lead		
1	Curb	} Cock Valve T.S. & V. $\frac{3}{4}$ in.	\$
1	Service box	} Short $3\frac{1}{2} \times 4\frac{1}{2}$ Long $4\frac{1}{2} \times 5\frac{1}{2}$	\$
	Old returned		
11	Ft. $\frac{3}{4}$ in.	} Copper Pipe at	\$
	Nipples	in. at	\$
	Bushings	to in. at	\$
1	Redg In'g	} Coupl'gs BRASS to in. at	\$
	Union	in. at	\$
	Meter	in. at	\$
			\$
	Compound Joints	at	\$
	Maintenance Foreman		\$
	Hrs. Water Maint. Man—1	at	\$
	Hrs. Water Maint. Man—2	at	\$
	Hrs. Garage Foreman	at	\$
	Hrs. Labor—	at	\$
	Hrs. Compressor	at	\$
			\$
	Trucking		\$
	Pav't Patch		\$
			\$
			\$
			\$
			\$

St. ELM  
 Ave. No. 49

Name of Owner \_\_\_\_\_

Labor and Mat'l. Report AUG. 1926

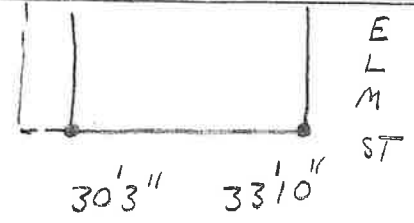

● Curb Box

6" Main PINE ST.  
 Elev. of Main at tap 4'

Gate at ● Gate at

● Curb Box