


LABOR AND MATERIALS

1	Copper	} Connection <u>3/4"</u>	\$
	Lead		
1	Curb	} <u>3/4</u> in.	\$
	Cock Valve		
	T.S. & V.		
1	Service box	} Short $3\frac{1}{2} \times 4\frac{1}{2}$ Long $4\frac{1}{2} \times 5\frac{1}{2}$ Buff or Rdway	\$
	Old returned		
7	Ft. <u>3/4</u> in.	} Pipe at	\$
	Nipples	in. at	\$
	Bushings	to in. at	\$
	Red'g }		
	Inc'g }	Coupl'gs to in. at	\$
	Union	in. at	\$
	Meter	in. at	\$
	Lead Joints	at	\$
	Compound Joints	at	\$
	Maintenance Foreman		\$
	Hrs. Water Maint. Man-1	at	\$
	Hrs. Water Maint. Man-2	at	\$
	Hrs. Garage Foreman	at	\$
	Hrs. Labor	at	\$
	Hrs. Compressor	at	\$
	Compensation Ins. at \$	per C	\$
	Trucking		\$
	Pav't Patch		\$
	<u>Tap Oct 12, 1979</u>		\$
			\$
			\$
	O'head		\$
			\$

St. Pl. Ave. No. 51  
 Name of Owner Elm  
Tony Poulos  
 Labor and Mat'l. Report Oct 12 1979

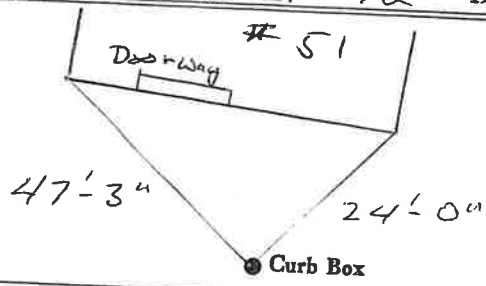

6" Main Elev. of Main at tap \_\_\_\_\_  
 Gate at ● Gate at ●  
 ● Curb Box