

LABOR AND MATERIALS

1	Copper Lead	Connection	3/4	\$ 1.31
1	Curb	Cock Valve T. S. & V.	3/4 in.	\$ 1.75
1	Service Box	Short 3/4x4 1/2		\$ 1.60
	Old returned	Long 4 1/2x5 1/2		
23	Ft.	3/4 in.	Copper Galv. Iron Cast Iron	Pipe at 18 \$ 4.14
	Nipples	in. at		\$
	Bushings	to in. at		\$
	Red'g Inc'g	Couplings to in. at		\$
	Union	in. at		\$
	Meter	in. at		\$
	Lead Joints	at		\$
	Leadite Joints	at		\$
	Hrs. Foreman	at		\$
6	Hrs. Chauffeur	at		\$ 3.75
2 1/2	Hrs. Tapper	at		\$ 7.56
21	Hrs. Labor	at 45		\$ 9.45
	Hrs. Labor	at		\$
	Hrs. Compressor	at		\$
	Compensation Ins.			\$ .45
	Trucking			\$ 1.00
	Builders Use of Water			\$
	Tap by Miller			\$
				\$
				\$
				\$
				\$
				\$ 25.01

76 -- 1940

St.

Elm

Pl.


Ave. No. 68

Name of Owner

Mrs Susie B Hill

Labor and Mat'l. Report

June 20 1940

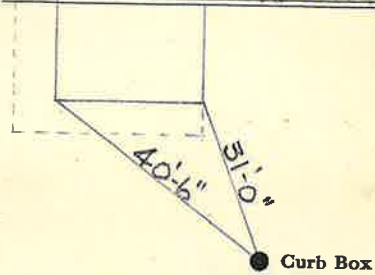

6" Main

Elev. of Main at tap 6'

Gate at ●

● Gate at

● Curb Box