


LABOR AND MATERIALS

1	Copper Lead	Connection	1 1/2"	\$	12.37
1	Curb	Cock Valve T.S. & V.	1 1/2 in.	\$	13.45
1	Service box Old returned	Short 3 1/2 x 4 1/2 Long 4 1/2 x 5 1/2 Buff or Rdway		\$	11.09
8	Ft. 1 1/2 in.	Copper C.I. C.I.	Pipe at 79	\$	6.32
	Nipples	in. at		\$	
	Bushings	to in. at		\$	
	Red'g Inc'g	Coupl'gs to in. at		\$	
	Union	in. at		\$	
	Meter	in. at		\$	
	Lead Joints at			\$	
	Compound Joints at			\$	
9	Maintenance Foreman	1.51		\$	13.59
	Hrs. Water Maint. Man-1 at			\$	
5	Hrs. Water Maint. Man-2 at	1.24		\$	6.20
	Hrs. Garage Foreman at			\$	
24	Hrs. Labor	at 1.13		\$	27.12
	Hrs. Compressor at			\$	
	Compensation Ins. at \$	4.29 per C		\$	2.01
	Trucking			\$	1.50
	Pav't Patch			\$	28.00
	Tap by Gissard			\$	
		12-28-54		\$	
	O'head			\$	
				\$	
				\$	171.65

St. 13-17
 Pt. Ave. No.

ELM
 Name of Owner
 Savoy Apartments
 McPhillips
 Labor and Mat'l. Report Dec. 28 1954

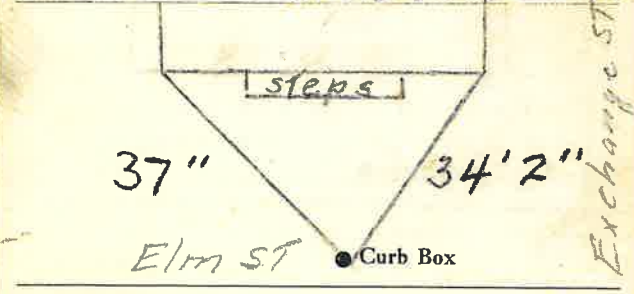

6" Main Elev. of Main at tap 5 1/2"

Gate at • Gate at •
 • Curb Box