


LABOR AND MATERIALS

1	Copper	Connection } $\frac{3}{4}$ "	\$	
1	Lead			
1	Curb	Cock } $\frac{3}{4}$ in.	\$	
			Valve } $\frac{3}{4}$ in.	
		T. S. & V.		
1	Service box	[Short $3\frac{1}{2}$ x $4\frac{1}{2}$]	\$	
	Old returned			[Long $4\frac{1}{2}$ x $5\frac{1}{2}$]
				[Buff or Rdway]
33	Ft. $\frac{3}{4}$ in.	[Copper]	\$	
		[G. I.]		
		[C. I.]		
	Nipples	in. at	\$	
	Bushings	to in. at	\$	
	Red'g } Inc'g }	Coupl'gs to in. at	\$	
	Union	in. at	\$	
	Meter	in. at	\$	
	Lead Joints	at	\$	
	Compound Joints	at	\$	
	Maintenance Foreman		\$	
	Hrs. Water Maint. Man-1	at	\$	
	Hrs. Water Maint. Man-2	at	\$	
	Hrs. Garage Foreman	at	\$	
	Hrs. Labor	at	\$	
	Hrs. Compressor	at	\$	
	Compensation Ins. at \$	per C	\$	
	Trucking		\$	
	Pay't Patch		\$	
	<i>Tap by G. L. Ford & Co.</i>		\$	
	<i>April 12-62</i>		\$	
	O'head		\$	

St. Empire
Pl. Ave. No. 1

Name of Owner Corusone

Labor and Mat'l. Report April 12 1962

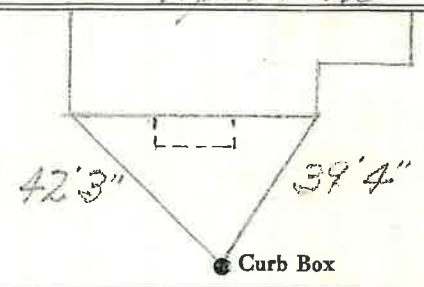

6 " Main Elev. of Main at tap 4'
Gate at • Gate at •

