

LABOR AND MATERIALS

1	Copper	{ Connection	3/4"	\$	3.04
1	Curb	{ Cock Valve T.S. & V.	3/4" in.	\$	3.54
1	Service box Old returned	{ Short 3 1/2 x 4 1/2 Long 4 1/2 x 5 1/2 Buff or Rdway		\$	4.70
28	Ft.	{ Copper Pipe	3/4 in.	\$	9.80
	Nipples	in. at		\$	
	Bushings	to in. at		\$	
	Red'g Inc'g	{ Coupl'gs to in. at		\$	
	Union	in. at		\$	
	Meter	in. at		\$	
	Lead Joints at			\$	
	Compound Joints at			\$	
	Hrs. Water Maint. Man-1 at			\$	
	Hrs. Water Maint. Man-2 at			\$	
3	Hrs. Labor	A.M. at 1.26		\$	3.78
14	Hrs. Labor	at 1.07		\$	14.98
	Hrs. Compressor at			\$	
	Compensation Ins. at \$2.66 per C.			\$	4.8
	Trucking			\$	1.00
	Pav't Patch			\$	11.03
	Tap by Gifford + Beirak			\$	
		4-4-51		\$	
	O'head			\$	
				\$	51.65

406


12-1951

Empire

Ave. No. 3

Name of Owner
Fredella

Labor and Mat'l. Report 4 - 4 - 1951

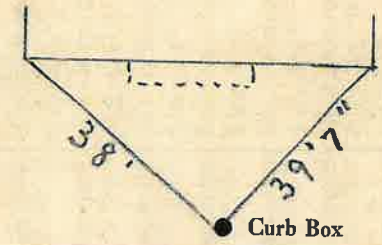

6" Main Elev. of Main at tap 4 1/2'

Gate at ● Gate at

● Curb Box