

LABOR AND MATERIALS

1	Copper	} Connection		\$
	Lead			
1	Curb	} Cock Valve T.S. & V.	} 2 in.	\$
1	Service box	} Short 3 1/2 x 4 1/2	} Long 4 1/2 x 5 1/2	\$
	Old returned			
30	Ft.	} Copper	} Pipe at	\$
	3/4 in.			
	Nipples	in. at		\$
	Bushings	to in. at		\$
	Red'g	} Coupl'gs	} to in. at	\$
	Inc'g			
	Union	in. at		\$
	Meter	in. at		\$
				\$
	Compound Joints	at		\$
	Maintenance Foreman			\$
	Hrs. Water Maint. Man—1	at		\$
	Hrs. Water Maint. Man—2	at		\$
	Hrs. Garage Foreman	at		\$
	Hrs. Labor—	at		\$
	Hrs. Compressor	at		\$
				\$
	Trucking			\$
	Pav't Patch			\$
				\$
				\$
				\$
				\$


EVERTS

St. Ave. No. 12

Name of Owner

Labor and Mat'l. Report

AUG. 17 1936

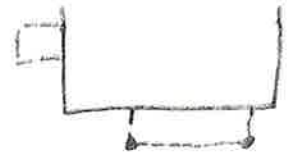

31-9 33-3

● Curb Box

6" Main (C.D. 1959)

Elev. of Main at tap 45'

Gate at ●

● Gate at

● Curb Box

NEW TAP