

### Labor and Materials

|                            |   |       |           |
|----------------------------|---|-------|-----------|
| 1...Copper                 | } Connection.. 3/4"                                       | ..... | \$. 1.25  |
| 1...Lead                   |   |       |           |
| 1...Curb                   | { Cock Valve T.S.&V. } 3/4 in                             | ..... | \$. 1.70  |
| 1...Service Box            |   |       |           |
| 1...Old returned           | { Short 3 1/2 x 4 1/2 Long 4 1/2 x 5 1/2 } Buff. or Rdway | ..... | \$. 1.37  |
| 19... Ft. 3/4 in.          | { Copper Galv. Iron Cast-Iron } Pipe at 13/16             | ..... | \$. 2.57  |
| .....Nipples               | .....in. at   | ..... | \$.       |
| .....Bushings              | .....to .....in. at                                       | ..... | \$.       |
| .....Red'g Inc'g           | { Couplings.....to .....in. at                            | ..... | .....\$.  |
| .....Union.....in. at      |   |       |           |
| .....Meter.....in. at      | .....   | ..... | .....\$.  |
| .....Lbs. Br. Stone at     | .....   | ..... | .....\$.  |
| .....Lbs. Sand at          | .....   | ..... | .....\$.  |
| .....Bags Cement at        | .....   | ..... | .....\$.  |
| .....Paving Brick          | { Mack Red Asphalt } at                                   | ..... | .....\$.  |
| .....Lead Joints at        |   |       |           |
| .....Leadite Joints at     | .....   | ..... | .....\$.  |
| 10...Hrs. Foreman at       | 62.17   | ..... | \$. 6.25  |
| 16...Hrs. Common Labor at  | 45  | ..... | \$. 7.20  |
| .....Hrs. Common Labor at  | .....   | ..... | .....\$.  |
| .....Hrs. Mason at         | .....   | ..... | .....\$.  |
| .....Hrs. Masons Helper at | .....   | ..... | .....\$.  |
| 3...Hrs. Compressor at     | 1.50  | ..... | \$. 4.50  |
| .....Compensation Ins      | .....   | ..... | .....\$.  |
| .....Trucking              | .....   | ..... | .....\$.  |
| .....Builders Use of Water | Patch   | ..... | .....\$.  |
| Total                      |   |       | \$. 35.35 |


1935-84

Labor and Material Report

August

1935

3/4" tap at 17 Exchange St.

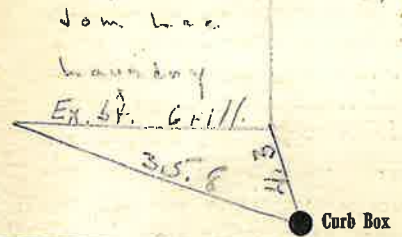

2" gal 8" Transite Main

Elev. of Main at tap 5

Gate at ● ● Gate at

● Curb Box

old tap to be dug up 1935

Was Brass Rail Razed 1967

shut off at curb.