


LABOR AND MATERIALS

1	Copper	} Connection	$\frac{3}{4}$	in.	\$
	Lead				
1	Curb	} Cock Valve T.S. & V.	$\frac{3}{4}$	in.	\$
1	Service box	} Short $3\frac{1}{2}$ x $4\frac{1}{2}$	}		\$
	Old returned				
12	Ft.	} Copper	$\frac{3}{4}$	in.	\$
		} Pipe at			\$
	Nipples	in.	at	\$	
	Bushings	to	in.	at	\$
	Red'g	} Coupl'gs	to	in.	at
	Inc'g				
	Union	in.	at	\$	
	Meter	in.	at	\$	
				\$	
	Compound Joints	at		\$	
	Maintenance Foreman			\$	
	Hrs. Water Maint. Man-1	at		\$	
	Hrs. Water Maint. Man-2	at		\$	
	Hrs. Garage Foreman	at		\$	
	Hrs. Labor	at		\$	
	Hrs. Compressor	at		\$	
				\$	
	Trucking			\$	
	Pav't Patch			\$	
				\$	
				\$	
				\$	
				\$	

St. PL Ave. No. 18
 EXCHANGE

Name of Owner
 LOOMIS

Labor and Mat'l. Report
 AUG 10 19 35

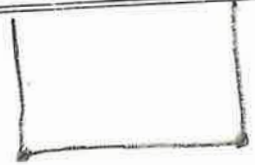

14.7 9.7

● Curb Box

8 Main (TRANSITE) Elev. of Main at tap 5'

Gate at ● Gate at

TAX ID # 302.20-28-1

● Curb Box

OLD TAP SHUT OFF AT MAIN