

# LABOR AND MATERIALS


_____	Copper } Connection _____	\$ _____
_____	Lead } _____	\$ _____
_____	Curb } Cock _____	\$ _____
_____	Valve } _____ in. _____	\$ _____
_____	T.S. & V. } _____	\$ _____
_____	Service box { Short 3-1/2 x 4-1/2 }	\$ _____
_____	Old returned { Long 4-1/2 x 5-1/2 }	\$ _____
_____	Ft. _____ in. { Copper } Pipe at _____	\$ _____
_____	G.I. } _____	\$ _____
_____	C.I. } _____	\$ _____
_____	Nipples _____ in. at _____	\$ _____
_____	Bushings _____ to _____ in. at _____	\$ _____
_____	Red'g _____	\$ _____
_____	Inc'g _____	\$ _____
_____	Union _____ in. at _____	\$ _____
_____	Meter _____ in. at _____	\$ _____
_____	_____	\$ _____
_____	Compound Joints at _____	\$ _____
_____	Maintenance Foreman _____	\$ _____
_____	Hrs. Water Maint. Man - 1 at _____	\$ _____
_____	Hrs. Water Maint. Man - 2 at _____	\$ _____
_____	Hrs. Garage Foreman _____ at _____	\$ _____
_____	Hrs. Labor _____ at _____	\$ _____
_____	Hrs. Compressor at _____	\$ _____
_____	_____	\$ _____
_____	Trucking _____	\$ _____
_____	Pav't Patch _____	\$ _____
_____	_____	\$ _____
_____	_____	\$ _____
St. \_\_\_\_\_  
Pl. \_\_\_\_\_  
Ave. No. \_\_\_\_\_

Name of Owner \_\_\_\_\_

8 FAXON + ARLINGTON

Labor and Mat'l. Report 19 \_\_\_\_\_

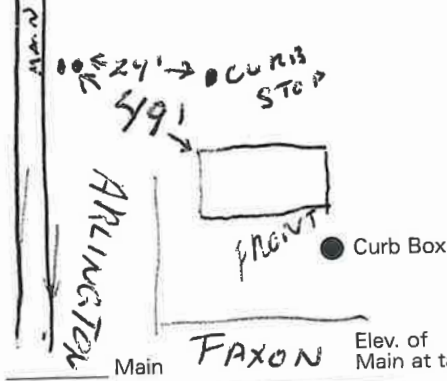

Gate at ●

● Gate at

OUTSIDE  
CLEANOUT DOUBLE

● Curb Box

TAX ID # 309.16-7-2.2

# LABOR AND MATERIALS

Copper } Connection _____ \$ _____	
Lead } _____ \$ _____	
Curb } Cock Valve } _____ in. _____ \$ _____	
	T.S. & V. }
Service box { Short 3-1/2 x 4-1/2 } _____ \$ _____	
Old returned { Long 4-1/2 x 5-1/2 } _____ \$ _____	
Ft. _____ in. { Copper } Pipe at _____ \$ _____	
	{ G.I. }
	{ C.I. }
Nipples _____ in. at _____ \$ _____	
Bushings _____ to _____ in. at _____ \$ _____	
Red'g _____ \$ _____	
Inc'g _____ \$ _____	
Union _____ in. at _____ \$ _____	
Meter _____ in. at _____ \$ _____	
_____ \$ _____	
Compound Joints at _____ \$ _____	
Maintenance Foreman _____ \$ _____	
Hrs. Water Maint. Man - 1 at _____ \$ _____	
Hrs. Water Maint. Man - 2 at _____ \$ _____	
Hrs. Garage Foreman _____ at _____ \$ _____	
Hrs. Labor _____ at _____ \$ _____	
Hrs. Compressor at _____ \$ _____	
_____ \$ _____	
Trucking _____ \$ _____	
Pav't Patch _____ \$ _____	
_____ \$ _____	
_____ \$ _____	
St. \_\_\_\_\_  
 Pl. \_\_\_\_\_  
 Ave. No. 8

Name of Owner  
FAXON ST  
7/26/06  
 Labor and Mat'l. Report # 2006

Left side of house

● Curb Box

\_\_\_\_\_ Main Elev. of Main at tap \_\_\_\_\_

Gate at ● Gate at ●

● Curb Box

TAP ON LEFT side of house on paper road ARLINGTON EX