

LABOR AND MATERIALS

_____	Copper } Connection _____	\$ _____
_____	Lead } _____	\$ _____
_____	Curb } Cock Valve _____ in. _____	\$ _____
_____	_____ } T.S. & V. _____	\$ _____
_____	Service box { Short 3-1/2 x 4-1/2 } _____	\$ _____
_____	Old returned { Long 4-1/2 x 5-1/2 } _____	\$ _____
_____	Ft. _____ in. { Copper } Pipe at _____	\$ _____
_____	_____ } G.I. _____	\$ _____
_____	_____ } C.I. _____	\$ _____
_____	Nipples _____ in. at _____	\$ _____
_____	Bushings _____ to _____ in. at _____	\$ _____
_____	Red'g _____	\$ _____
_____	Inc'g _____	\$ _____
_____	Union _____ in. at _____	\$ _____
_____	Meter _____ in. at _____	\$ _____
_____	_____	\$ _____
_____	Compound Joints at _____	\$ _____
_____	Maintenance Foreman _____	\$ _____
_____	Hrs. Water Maint. Man - 1 at _____	\$ _____
_____	Hrs. Water Maint. Man - 2 at _____	\$ _____
_____	Hrs. Garage Foreman _____ at _____	\$ _____
_____	Hrs. Labor _____ at _____	\$ _____
_____	Hrs. Compressor at _____	\$ _____
_____	_____	\$ _____
_____	Trucking _____	\$ _____
_____	Pav't Patch _____	\$ _____
_____	_____	\$ _____
_____	_____	\$ _____
_____	_____	\$ _____
_____	_____	\$ _____

St. _____
Pl. _____
Ave. No. 10

Name of Owner

FAYON ST

Labor and Mat'l. Report

7/26/06
19 2006

TAP ON FRANKIN

RIGHT
SIDE OF
HOUSE

● Curb Box

_____ Main

Elev. of
Main at tap _____

Gate at ●

● Gate at

● Curb Box

TAP ON
FRANKIN side

LABOR AND MATERIALS


Copper	} Connection		\$	
Lead				
Curb	} Cock	in.	\$	
				} Valve
Service box	} Short 3½ x 4½			
Old returned		} Long 4½ x 5½		\$
38' Ft.	} Copper	} Pipe at	\$	
3/4 in.				} G.I.
41'				
Nipples	in. at		\$	
Bushings	to in. at		\$	
Red'g	} Coupl'gs	to in. at	\$	
Inc'g				
Union	in. at		\$	
Meter	in. at		\$	
			\$	
Compound Joints	at		\$	
Maintenance Foreman			\$	
Hrs. Water Maint. Man-1	at		\$	
Hrs. Water Maint. Man-2	at		\$	
Hrs. Garage Foreman	at		\$	
Hrs. Labor	at		\$	
Hrs. Compressor	at		\$	
			\$	
Trucking			\$	
Pav't Patch			\$	
			\$	
			\$	
			\$	
			\$	

FAXON

St. Pl. Ave. No. 10

Name of Owner
SCOTT DUFF

Labor and Mat'l. Report 19 96

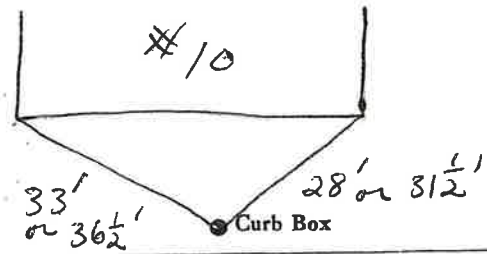

FAXON

Main Elev. of Main at tap
Gate at • Gate at •

• Curb Box

TAP ON FAXON ST