

LABOR AND MATERIALS

Copper } Connection \_\_\_\_\_ \$ \_\_\_\_\_  
 Lead }  
 Curb } Cock } \_\_\_\_\_ in. \$ \_\_\_\_\_  
 } Valve }  
 } T. S. & V. }  
 Service box { Short 3½ x 4½ } \_\_\_\_\_ \$ \_\_\_\_\_  
 Old returned { Long 4½ x 5½ }  
 29' 8" Ft. ¾ in. { Copper } Pipe at \_\_\_\_\_ \$ \_\_\_\_\_  
 } ~~G.I.~~  
 } ~~G.I.~~  
 Nipples \_\_\_\_\_ in. at \_\_\_\_\_ \$ \_\_\_\_\_  
 Bushings \_\_\_\_\_ to \_\_\_\_\_ in. at \_\_\_\_\_ \$ \_\_\_\_\_  
 Red'g } Coupl'gs \_\_\_\_\_ to \_\_\_\_\_ in. at \_\_\_\_\_ \$ \_\_\_\_\_  
 Inc'g }  
 Union \_\_\_\_\_ in. at \_\_\_\_\_ \$ \_\_\_\_\_  
 Meter \_\_\_\_\_ in. at \_\_\_\_\_ \$ \_\_\_\_\_  
 \_\_\_\_\_ \$ \_\_\_\_\_  
 Compound Joints at \_\_\_\_\_ \$ \_\_\_\_\_  
 Maintenance Foreman \_\_\_\_\_ \$ \_\_\_\_\_  
 Hrs. Water Maint. Man-1 at \_\_\_\_\_ \$ \_\_\_\_\_  
 Hrs. Water Maint. Man-2 at \_\_\_\_\_ \$ \_\_\_\_\_  
 Hrs. Garage Foreman \_\_\_\_\_ at \_\_\_\_\_ \$ \_\_\_\_\_  
 Hrs. Labor- \_\_\_\_\_ at \_\_\_\_\_ \$ \_\_\_\_\_  
 Hrs. Compressor at \_\_\_\_\_ \$ \_\_\_\_\_  
 \_\_\_\_\_ \$ \_\_\_\_\_  
 Trucking \_\_\_\_\_ \$ \_\_\_\_\_  
 Pav't Patch \_\_\_\_\_ \$ \_\_\_\_\_  
 \_\_\_\_\_ \$ \_\_\_\_\_  
 \_\_\_\_\_ \$ \_\_\_\_\_  
 \_\_\_\_\_ \$ \_\_\_\_\_  
 \_\_\_\_\_ \$ \_\_\_\_\_

FAXON


St. ~~Pl.~~ Ave. No. 26

Name of Owner

Cranell

Labor and Mat'l. Report

1988

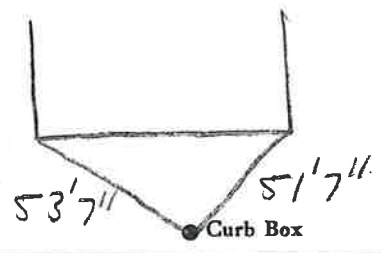

Main \_\_\_\_\_ Elev. of Main at tap \_\_\_\_\_  
 Gate at • \_\_\_\_\_ Gate at \_\_\_\_\_

• Curb Box