


### Labor and Materials

1	Copper } Connection	3/4"			\$ 3.20
	Lead				
1	Curb } Cock	} 3/4" in.			
	Valve				
	T.S. & V.				\$ 1.00
1	Service Box	Short 3 1/2 x 4 1/2	}		
	Old returned	Long 4 1/2 x 5 1/2			
		Buff. or Redway			\$
24	Ft. 3/4 in.	Copper } Pipe at			\$ 5.28
		Galv. Iron			
		Cast Iron			
	Nipples	in. at			\$
	Bushings	to in. at			\$
1	Red'g } Couplings	to in. at			\$ 1.18
	Inc'g				
	Union	in. at			\$
	Meter	in. at			\$
	Lbs. Br. Stone	at			\$
	Lbs. Sand	at			\$
	Bags Cement	at			\$
	Paving Brick	} at			
			Mack		
		Red			
		Asphalt			
	Lead Joints	at			\$
	Leadite Joints	at			\$
5	Hrs. Foreman	at	6 1/2		\$ 3.75
4	Hrs. Common Labor	at	50		\$ 2.00
12	Hrs. Common Labor	at	40 1/2		\$ 4.88
	Hrs. Mason	at			\$
	Hrs. Mason's Helper	at			\$
	Hrs. Compressor	at			\$
	Compensation Ins.				\$ 2.8
	Trucking				\$ 1.00
	Builders' Use of Water				\$
Total					\$ 21.57

27-172  
Labor and Material Report

1917

3/4" tap at 3 First St.

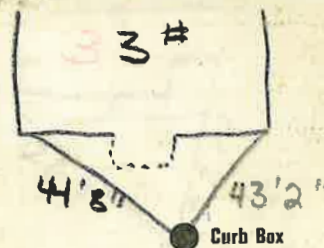

6" Main

Elev. of Main at tap

4 1/2"

Gate at

Gate at

TAX ID # 309.12-2-6

Curb Box

Old tap shut off