


LABOR AND MATERIALS

1	Copper Lead	} Connection	3/4	\$	
1	Curb	} Cock Valve T.G. & V.	3/4 in.	\$	
	Service box	{ Short 3-1/2 x 4-1/2		\$	
	Old returned	{ long 4-1/2 x 5-1/2		\$	
9	Ft.	3/4 in. { Copper SI. SI.	} Pipe at	\$	
	Nipples		in. at	\$	
	Bushings		to in. at	\$	
	Red'g				
	Inc'g				
	Union		in. at	\$	
	Meter		in. at	\$	
				\$	
	Compound Joints at			\$	
	Maintenance Foreman			\$	
	Hrs. Water Maint. Man - 1 at			\$	
	Hrs. Water Maint. Man - 2 at			\$	
	Hrs. Garage Foreman		at	\$	
	Hrs. Labor		at	\$	
	Hrs. Compressor at			\$	
				\$	
	Trucking			\$	
	Pav't Patch			\$	
				\$	
				\$	
St. FIRST
 Ave. No. 10

Name of Owner _____
 TAX ID # 309.12-9-11

Labor and Mat'l. Report AUG. 23, 1927

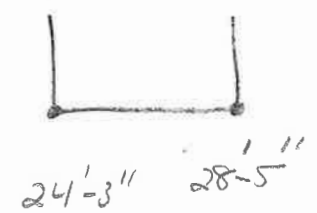

● Curb Box

6" Main Elev. of Main at tap 4 1/2'

Gate at ● ● Gate at

● Curb Box