

Labor and Materials

1	Copper Lead	Connection	3/4	\$	1.23
1	Curb	Cock Valve T-S. & V.	3/4 in	\$	1.68
1	Service Box Old-retained	Short 3 1/2 x 4 1/2 Long 4 1/2 x 5 1/2 Buff. or Rdway		\$	1.75
9	Ft. 3/4 in.	Copper Galv-iron Cast-iron	Pipe at .15	\$	1.35
	Nipples	in. at		\$	
	Bushings	to in. at		\$	
	Red'g Inc'g	Couplings to in. at		\$	
	Union	in. at		\$	
	Meter	in. at		\$	
	Lead Joints	at		\$	
	Leadite Joints	at		\$	
	Hrs. Foreman	at		\$	
2	Hrs. Chauffeur	at	6 1/2	\$	1.25
7	Hrs. Tapper	at		\$	4.38
7	Hrs. Labor	at	4 1/2	\$	3.15
	Hrs. Labor	at		\$	
	Hrs. Compressor	at		\$	
	Compensation Ins.			\$.27
	Trucking			\$	1.00
	Builders Use of Water			\$	
	Tapp. Hessel			\$	
	Patch			\$	5.00
				\$	
				\$	21.06

18 - 1938


St. Ph
Ave. No. 11

First

Name of Owner

D'Angelo

Labor and Mat'l. Report 5-6-38 19

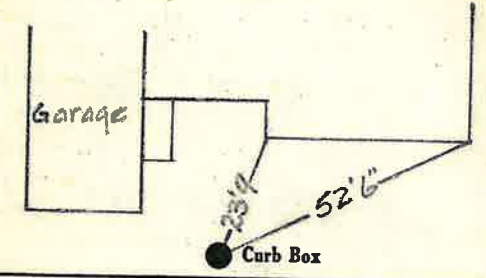

4" Main Spring St. Elev. of Main at tap 5 1/2

Gate at ● Gate at ●

● Curb Box

Shut off at Curb
3/19/34
Booher