

### LABOR AND MATERIALS

1	Copper	Connection	3/4	in.	\$ 1.25	
1	Curb	Cock Valve	3/4	in.	\$ 1.68	
1	Service Box	Short 3 1/2 x 4 1/2			\$ 1.75	
	Old returned	long 4 1/2 x 5 1/2				
		Buffer on Rdway				
7	Ft.	3/4	in.	Pipe at 15	\$ 1.05	
	Nipples	in.	at		\$	
	Bushings	to	in.	at	\$	
	Red'g	Couplings	to	in.	at	
	Inc'g					
	Union	in.	at		\$	
	Meter	in.	at		\$	
	Lead Joints	at			\$	
	Leadite Joints	at			\$	
	Hrs. Foreman	at			\$	
3	Hrs. Chauffeur	at			\$ 1.88	
	Hrs. Tapper	at			\$	
4	Hrs. Labor	at			\$ 3.60	
	Hrs. Labor	at			\$	
	Hrs. Compressor	at			\$	
	Compensation Ins.				\$ 17	
	Trucking				\$ 1.00	
	Builders Use of Water	Patch			\$ 5.00	
	Total by Miller					\$
					\$	
					\$	
					\$	
					\$	
					\$ 17.36	

1 0 0 - 1938

~~St~~ 18  
~~Pl~~  
Ave. No. 14

*Flamdreux*


Name of Owner

*Norton*

Labor and Mat'l. Report

Aug 29 1938

See below

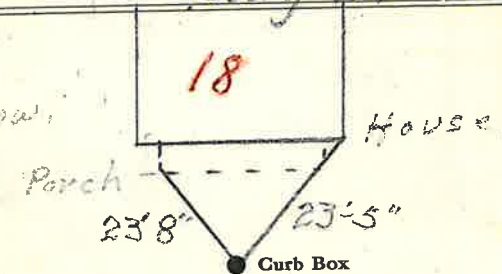


4" Main

Elev. of Main at tap 5

Gate at ●

● Gate at

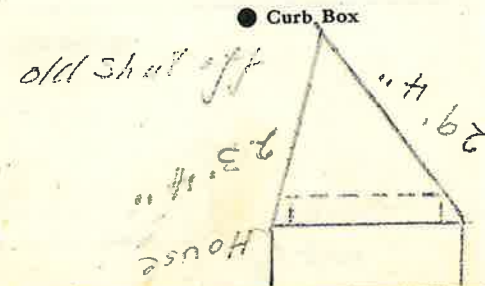

100 - 1938


Flanchaux  
st  
pt  
Ave. No. 14

Name of Owner

Norton

Labor and Mat'l. Report City 29 1938

See below

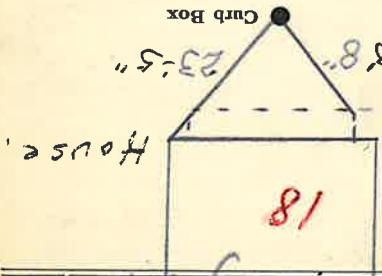

Elev. of Main at tap 5

Main 4"

Gate at

Gate at

