


LABOR AND MATERIALS

1	Copper Lead	} Connection $\frac{3}{4}$ "	\$
1	Curb		} Cock <i>Oris</i> $\frac{3}{4}$ in.
1	Service box	} Short $3\frac{1}{2}$ x $4\frac{1}{2}$ Long $4\frac{1}{2}$ x $5\frac{1}{2}$ Buff or Rdway	
	Old returned		
7	Ft. $\frac{3}{4}$ in.		} Copper C.I. C.I.
	Nipples	in. at \$	
	Bushings	to in. at \$	
	Red'g } Inc'g }	} Coupl'gs	to in. at \$
	Union		in. at \$
	Meter	in. at \$	
	Lead Joints	at \$	
	Compound Joints	at \$	
	Maintenance Foreman	\$	
	Hrs. Water Maint. Man-1	at \$	
	Hrs. Water Maint. Man-2	at \$	
	Hrs. Garage Foreman	at \$	
	Hrs. Labor	at \$	
	Hrs. Compressor	at \$	
	Compensation Ins. at \$	per C \$	
	Trucking	\$	
	Pav't Patch	\$	
	<i>Topsy Gifford etc</i>	\$	
	<i>(April 22-68)</i>	\$	
	O'head	\$	

Flandreau St. Pl. Ave. No. *20*

Name of Owner
Richard J. Conter

Labor and Mat'l. Report *April 22* 19*68*

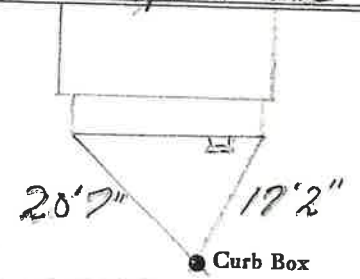

4" Main Elev. of Main at tap *4*'
Gate at • Gate at

• Curb Box

*Old Galv Water Service
3/4" Remove from main by
Gifford. April 22 68*