


LABOR AND MATERIALS

1	Copper } Connection $\frac{1}{2}$ "	\$
1	Lead } Curb } Cock Valve } $\frac{3}{4}$ " in.	\$
1	Service box { Short 3-1/2 x 4-1/2 } Old returned { Long 4-1/2 x 5-1/2 }	\$
8	Ft. $\frac{3}{4}$ in. { Copper } Pipe at	\$
1	Nipples $\frac{1}{2}$ " in. at	\$
	Bushings _____ to _____ in. at	\$
1	Red'g coup $\frac{3}{4}$ " to $\frac{1}{2}$ "	
	Inc'g _____	
	Union _____ in. at	\$
	Meter _____ in. at	\$
	_____	\$
	Compound Joints at _____	\$
	Maintenance Foreman _____	\$
	Hrs. Water Maint. Man - 1 at _____	\$
	Hrs. Water Maint. Man - 2 at _____	\$
	Hrs. Garage Foreman _____ at _____	\$
	Hrs. Labor _____ at _____	\$
	Hrs. Compressor at _____	\$
	_____	\$
	Trucking _____	\$
	Pav't Patch _____	\$
	_____	\$
	_____	\$
St. FLANDREAUX Ave. No. 22

Name of Owner _____

Labor and Mat'l. Report 19 MAY 2, 1923

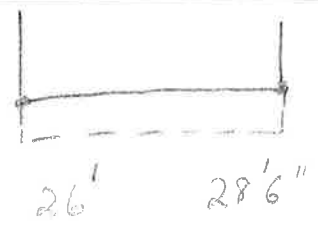

● Curb Box

4" Main Elev. of Main at tap 4'

Gate at ● Gate at ●

● Curb Box