

### LABOR AND MATERIALS

1	Copper	{ Connection	3/4		\$ 2.29
	Lead				
1	Curb	{ Cock Valve	3/4 in.		\$ 2.70
		{ T.S. & V.			
1	Service box	{ Short 3 1/2 x 4 1/2			\$ 4.25
	Old returned	{ Long 4 1/2 x 5 1/2			
		{ Buff or Rdway			
26	Ft. 3/4 in.	{ Copper	Pipe at	35	\$ 9.10
		{ G.I.			
		{ C.T.			
	Nipples	in. at			\$
	Bushings	to in. at			\$
	Red'g	{ Coupl'gs	to in. at		\$
	Inc'g				
	Union	in. at			\$
	Meter	in. at			\$
	Lead Joints at				\$
	Compound Joints at				\$
	Hrs. Water Maint. Man-1 at				\$
10	Hrs. Water Maint. Man-2 at		102		\$ 10.20
13	Hrs. Labor	at	91		\$ 11.83
	Hrs. Labor	at			\$
2	Hrs. Compressor at		1.20		\$ 2.40
	Compensation Ins. at \$	per C.			\$ 49
	Trucking				\$ 11.59
	Pav't Patch				\$
	Tap & Mfg				\$
	O'head				\$
					\$ 55.95

45-1950

St.  
Pl.  
Ave. No. 23


Flandreau Ave

Name of Owner

Starbach

Labor and Mat'l. Report

May 22 1950

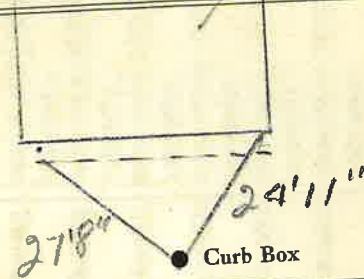

● Curb Box

4 Main

Elev. of  
Main at tap 5

Gate at ●

● Gate at

● Curb Box