

LABOR AND MATERIALS

1 Copper } Connection ^{3/4"} ----- \$
 Lead -----
 1 Curb { Cock } ^{3/4"} in. ----- \$
 { Valve }
 { T. S. & V. }
 1 Service Box { Short 3/2x4 1/2 } ----- \$
 Old returned { Long 4 1/2x5 1/2 }
 { Buff. or Rdway }
 7 Ft. ^{3/4"} in. { Copper } Pipe at ----- \$
 { Galv Iron }
 { Cast Iron }
 Nipples ----- in. at ----- \$
 Bushings ----- to ----- in. at ----- \$
 Red'g } Couplings ----- to ----- in. at ----- \$
 Inc'g }
 Union ----- in. at ----- \$
 Meter ----- in. at ----- \$
 Lead Joints at ----- \$
 Leadite Joints at ----- \$
 Hrs. Foreman at ----- \$
 Hrs. Chauffeur at ----- \$
 Hrs. Tapper at ----- \$
 Hrs. Labor at ----- \$
 Hrs. Labor at ----- \$
 Hrs. Compressor at ----- \$
 Compensation Ins. ----- \$
 Trucking ----- \$
 Builders Use of Water ----- \$
 Tap by Gifford & Co. ----- \$
 7-16-57 ----- \$
 ----- \$
 ----- \$
 ----- \$


St. ^V 24

Flandreaux Ave. No. 20

Name of Owner

Kingsley

Labor and Mat'l. Report July 16 1957

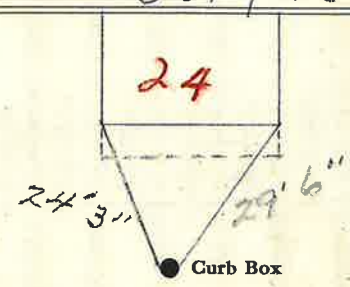

4" Main Elev. of Main at tap 5'
 Gate at ● ● Gate at

● Curb Box

LABOR AND MATERIALS


_____	Copper } Connection _____	\$ _____
_____	Lead } _____	\$ _____
_____	Curb } Cock } _____ in. _____	\$ _____
	} Valve } _____	
	} T.S. & V. } _____	
_____	Service box { Short 3-1/2 x 4-1/2 } _____	\$ _____
_____	Old returned { Long 4-1/2 x 5-1/2 } _____	\$ _____
_____	Ft. _____ in. { Copper } Pipe at _____	\$ _____
	} G.I. } _____	
	} C.I. } _____	
_____	Nipples _____ in. at _____	\$ _____
_____	Bushings _____ to _____ in. at _____	\$ _____
_____	Red'g _____	\$ _____
_____	Inc'g _____	\$ _____
_____	Union _____ in. at _____	\$ _____
_____	Meter _____ in. at _____	\$ _____
_____	_____	\$ _____
_____	Compound Joints at _____	\$ _____
_____	Maintenance Foreman _____	\$ _____
_____	Hrs. Water Maint. Man - 1 at _____	\$ _____
_____	Hrs. Water Maint. Man - 2 at _____	\$ _____
_____	Hrs. Garage Foreman _____ at _____	\$ _____
_____	Hrs. Labor _____ at _____	\$ _____
_____	Hrs. Compressor at _____	\$ _____
_____	_____	\$ _____
_____	Trucking _____	\$ _____
_____	Pav't Patch _____	\$ _____
_____	_____	\$ _____
_____	_____	\$ _____
_____ St. _____
 _____ Pl. _____
 _____ Ave. No. _____

Name of Owner _____

24 FLANDRAUX

Labor and Mat'l. Report 19 _____

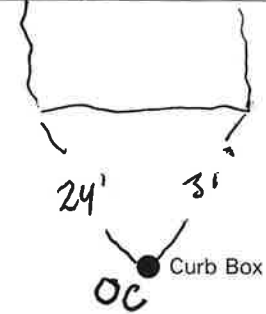

_____ Main

Elev. of Main at tap _____

Gate at ●

● Gate at _____

● Curb Box