


LABOR AND MATERIALS

1	Copper } Connection	3/4	\$
1	Curb } Cock	3/4 in.	\$
		Valve	
		T.S. & V.	
1	Service box	{ Short 3-1/2 x 4-1/2 }	\$
	Old returned	{ Long 4-1/2 x 6-1/2 }	\$
9	Ft. 3/4 in. { Copper }	Pipe at	\$
	Nipples	in. at	\$
	Bushings	to in. at	\$
	Red'g		
	Inc'g		
	Union	in. at	\$
	Meter	in. at	\$
			\$
	Compound Joints at		\$
	Maintenance Foreman		\$
	Hrs. Water Maint. Man - 1 at		\$
	Hrs. Water Maint. Man - 2 at		\$
	Hrs. Garage Foreman	at	\$
	Hrs. Labor	at	\$
	Hrs. Compressor at		\$
			\$
	Trucking		\$
	Pav't Patch		\$
			\$
			\$
			\$
			\$

FLANDREAU Ave. No. 8

Name of Owner _____

Labor and Mat'l. Report MAY 20, 1936

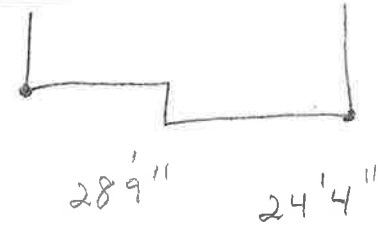

● Curb Box

4" Main Elev. of Main at tap 5'

Gate at ● Gate at ●

● Curb Box

OLD TAP DISCONNECTED