

LABOR AND MATERIALS

1	Copper Lead	Connection	$\frac{3}{4}$	\$ 1.23
1	Curb	Cock Valve	$\frac{3}{4}$ in.	\$ 1.68
		T. S. & V.		
1	Service Box	Old returned	Short $\frac{3}{2} \times \frac{4}{2}$	\$ 1.54
			Long $\frac{4}{2} \times \frac{5}{2}$	
			Buff. or Rdway	
35	Ft. $\frac{3}{4}$ in.	Pipe at	Copper	17 \$ 5.95
			Galv. Iron	
			Cast Iron	
	Nipples	in. at		\$
	Bushings	to in. at		\$
	Red'g Inc'g	Couplings	to in. at	\$
	Union	in. at		\$
	Meter	in. at		\$
	Lead Joints	at		\$
	Leadite Joints	at		\$
	Hrs. Foreman	at		\$
4	Hrs. Chauffeur	at 62 1/2		\$ 2.50
8	Hrs. Tapper	at 7		\$ 5.00
8	Hrs. Labor	at 45		\$ 3.60
	Hrs. Labor	at		\$
	Hrs. Compressor	at		\$
	Compensation Ins.			\$ .34
	Trucking			\$ 1.00
	Builders Use of Water	patch		\$ 5.00
	Tap by Messel			\$
				\$
				\$
				\$
				\$
				\$ 27.84


9 9 - - 1939

Str- 11  
Pl-  
Ave. No. 5

Flandreux

Name of Owner  
Gleason

Labor and Mat'l. Report Nov 24 1939

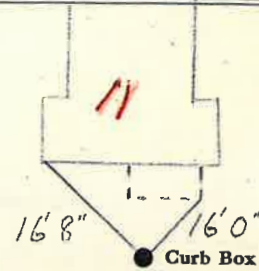

4 Main Elev. of Main at tap 5  
Gate at ● Gate at ●

TAX ID # 302.12-24-7

● Curb Box

old shut off