


LABOR AND MATERIALS

<u>1</u>	Copper } Connection <u>3/4</u>	\$	_____
<u>1</u>	Lead } Cock	\$	_____
<u>1</u>	Curb } Valve } <u>3/4</u> in.	\$	_____
	T.S. & V. }		
<u>1</u>	Service box { Short 3-1/2 x 4-1/2 }	\$	_____
	Old returned { Long 4-1/2 x 5-1/2 }	\$	_____
<u>26</u>	Ft. <u>3/4</u> in. { Copper }	\$	_____
	in. { Gal. }		
_____	Nipples _____ in. at _____	\$	_____
_____	Bushings _____ to _____ in. at _____	\$	_____
_____	Red'g _____	\$	_____
_____	Inc'g _____	\$	_____
_____	Union _____ in. at _____	\$	_____
_____	Meter _____ in. at _____	\$	_____
_____	_____	\$	_____
_____	Compound Joints at _____	\$	_____
_____	Maintenance Foreman _____	\$	_____
_____	Hrs. Water Maint. Man - 1 at _____	\$	_____
_____	Hrs. Water Maint. Man - 2 at _____	\$	_____
_____	Hrs. Garage Foreman _____ at _____	\$	_____
_____	Hrs. Labor _____ at _____	\$	_____
_____	Hrs. Compressor at _____	\$	_____
_____	_____	\$	_____
_____	Trucking _____	\$	_____
_____	Pav't Patch _____	\$	_____
_____	_____	\$	_____
_____	_____	\$	_____
FLANDREAU Ave. No. 13
 Name of Owner _____
 Labor and Mat'l. Report 19 AUG. 6, 1925

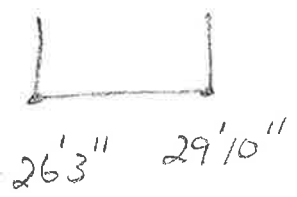

● Curb Box

4" Main Elev. of Main at tap 5'

Gate at ● ● Gate at

● Curb Box