


LABOR AND MATERIALS

1	Copper / Lead	Connection	3/4"	\$	2.76
1	Curb	Cock Valve	3/4" in.	\$	3.49
Same Service box (Short 3 1/2 X 4 1/2) Old returned (Long 4 1/2 X 5 1/2) Buff or Rdway					
9	Ft.	3/4" in.	Copper Pipe at	35	\$ 31.5
Nipples ..... in. at .....					
Bushings ..... to ..... in. at .....					
Red'g / Inc'g Coupl'gs ..... to ..... in. at .....					
Union ..... in. at .....					
Meter ..... in. at .....					
Lead Joints at .....					
Compound Joints at .....					
5	Hrs.	Water Maint. Man	1 at	1.52	\$ 7.60
Hrs. Water Maint. Man—2 at .....					
15 1/2	Hrs.	Labor	at	1.13	\$ 17.52
Hrs. Labor— ..... at .....					
Hrs. Compressor at .....					
Compensation Ins. at \$ 706 per C .....					
Trucking .....					
Pay't Patch .....					
Taphy. Bureau 9-19-52 .....					
O'head .....					
					\$48.60

Str. Flandreaux Ave. No. 14

Name of Owner Furlong

Labor and Mat'l. Report Sept 19 19 52

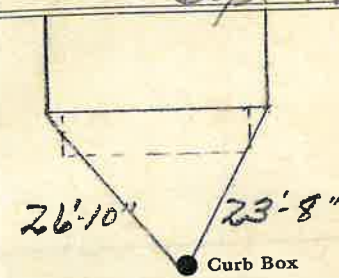

4" Main Elev. of Main at tap 4'

Gate at ● Gate at ●

● Curb Box