


LABOR AND MATERIALS

Copper } Connection _____	\$ _____
Lead } _____	\$ _____
Curb } Cock } _____ in.	\$ _____
} Valve } _____	
} T.S. & V. } _____	
Service box } Short 3 1/2 x 4 1/2 }	
Old returned } Long 4 1/2 x 5 1/2 }	\$ _____
Ft. in. } Copper } Pipe at _____	\$ _____
} G.I. }	
} C.I. }	
Nipples _____ in. at _____	\$ _____
Bushings _____ to _____ in. at _____	\$ _____
Red'g } Coupl'gs _____ to _____ in. at _____	\$ _____
Inc'g } _____	
Union _____ in. at _____	\$ _____
Meter _____ in. at _____	\$ _____
_____	\$ _____
Compound Joints at _____	\$ _____
Maintenance Foreman _____	\$ _____
Hrs. Water Maint. Man—1 at _____	\$ _____
Hrs. Water Maint. Man—2 at _____	\$ _____
Hrs. Garage Foreman _____ at _____	\$ _____
Hrs. Labor— _____ at _____	\$ _____
Hrs. Compressor at _____	\$ _____
_____	\$ _____
Trucking _____	\$ _____
Pav't Patch _____	\$ _____
_____	\$ _____
_____	\$ _____
_____	\$ _____
_____	\$ _____

FT. AMHERST CT.
ST.
PI.
Ave. No. 4

Name of Owner _____

Labor and Mat'l. Report 6/21 1990

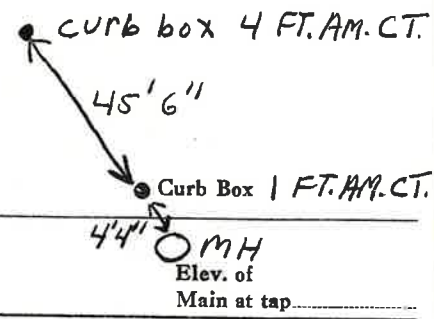

Gate at • _____ • Gate at _____

• Curb Box

Former Carriage House