


LABOR AND MATERIALS

1	Copper	Connection	3/4"	\$	_____
1	Curb	Cock	3/4" in.	\$	_____
1	Service box	Short 3-1/2 x 4-1/2		\$	_____
	Old returned	Long 4-1/2 x 5-1/2		\$	_____
8	Ft.	3/4 in. Copper	Pipe at	\$	_____
		Nipples	in. at	\$	_____
		Bushings	to in. at	\$	_____
		Red'g		\$	_____
		Inc'g		\$	_____
		Union	in. at	\$	_____
		Meter	in. at	\$	_____
				\$	_____
		Compound Joints	at	\$	_____
		Maintenance Foreman		\$	_____
		Hrs. Water Maint. Man - 1	at	\$	_____
		Hrs. Water Maint. Man - 2	at	\$	_____
		Hrs. Garage Foreman	at	\$	_____
		Hrs. Labor	at	\$	_____
		Hrs. Compressor	at	\$	_____
				\$	_____
		Trucking		\$	_____
		Pav't Patch		\$	_____
				\$	_____
				\$	_____
FOWLER Ave. No. 12
 Name of Owner _____

Labor and Mat'l. Report 1932, JUNE 11

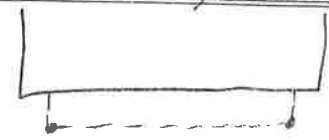

22-9 28-3

● Curb Box

6" Main Elev. of Main at tap 4 1/2'

Gate at ● Gate at ●

● Curb Box

NEW HOUSE