


LABOR AND MATERIALS

1	Copper } Connection $\frac{3}{4}$	\$
1	Curb } Cock Valve } $\frac{3}{4}$ in.	\$
1	Service box { Short 6-1/2 x 4-1/2 } Old returned { Long 4-1/2 x 5-1/2 }	\$
22	Ft. $\frac{3}{4}$ in. { Copper } Pipe at	\$
	Nipples _____ in. at	\$
	Bushings _____ to _____ in. at	\$
	Red'g	
	Inc'g	
	Union _____ in. at	\$
	Meter _____ in. at	\$
	Compound Joints at	\$
	Maintenance Foreman	\$
	Hrs. Water Maint. Man - 1 at	\$
	Hrs. Water Maint. Man - 2 at	\$
	Hrs. Garage Foreman _____ at	\$
	Hrs. Labor _____ at	\$
	Hrs. Compressor at	\$
	Trucking	\$
	Pav't Patch	\$
		\$
		\$
AVE. FREDELLA
 St. 7-9+11
 Ans. No. 7-9+11
 Name of Owner TRUST CO.

Labor and Mat'l. Report 1937, JUNE 1

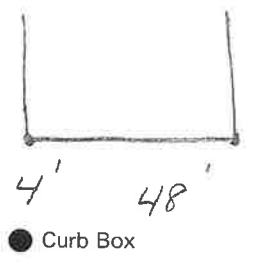

6" Main
 Elev. of Main at tap 5 1/2'
 Gate at ● Gate at ●

● Curb Box
 OLD SHUT OFF
 OFF IN ON POSITION