


# LABOR AND MATERIALS

|    |                           |                      |           |    |
|----|---------------------------|----------------------|-----------|----|
| 1  | Copper                    | Connection           | 3/4       | \$ |
| 1  | Curb                      | Cock Valve T.S. & V. | 3/4 in.   | \$ |
| 1  | Service box               | Short 3-1/2 x 4-1/2  |           | \$ |
|    | Old returned              | Long 4-1/2 x 5-1/2   |           | \$ |
| 21 | Ft.                       | 3/4 in. Copper       | Pipe at   | \$ |
|    | Nipples                   |                      | in. at    | \$ |
|    | Bushings                  |                      | to in. at | \$ |
|    | Red'g                     |                      |           | \$ |
|    | Inc'g                     |                      |           | \$ |
|    | Union                     |                      | in. at    | \$ |
|    | Meter                     |                      | in. at    | \$ |
|    | Compound Joints           |                      | at        | \$ |
|    | Maintenance Foreman       |                      |           | \$ |
|    | Hrs. Water Maint. Man - 1 |                      | at        | \$ |
|    | Hrs. Water Maint. Man - 2 |                      | at        | \$ |
|    | Hrs. Garage Foreman       |                      | at        | \$ |
|    | Hrs. Labor                |                      | at        | \$ |
|    | Hrs. Compressor           |                      | at        | \$ |
|    | Trucking                  |                      |           | \$ |
|    | Pav't Patch               |                      |           | \$ |
|    |                           |                      |           | \$ |
|    |                           |                      |           | \$ |
FREDELLA Ave. No. 15  
 Name of Owner

Labor and Mat'l. Report 19 31, MAY 21

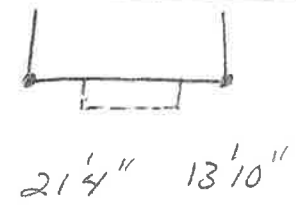

● Curb Box

6" Main Elev. of Main at tap 4'  
 Gate at ● Gate at ●

● Curb Box

OLD SHUT OFF