

LABOR AND MATERIALS


Copper	Connection	3/4			\$ 2.87
Lead					
Curb	Cock Valve	3/4	in.		\$ 3.62
	T. S. & V.				
Service box	Short 3 1/2 X 4 1/2				
Old returned	Long 4 1/2 X 5 1/2				
	Buff or Rdway				\$ 4.68
11. Ft. 3/4 in.	Copper		Pipe at	32	\$ 4.16
	G. I.				
	C. I.				
Nipples	in. at				\$
Bushings	to in. at				\$
Red'g					
Inc'g	Coupl'gs to in. at				\$
Union	in. at				\$
Meter	in. at				\$
Lead Joints	at				\$
Compound Joints	at				\$
4 Hrs. Water Maint. Man—1	at				\$ 1.49
3 Hrs. Water Maint. Man—2	at				\$ 3.06
6 Hrs. Labor—	at				\$ 7.28
Hrs. Labor—	at				\$
Hrs. Compressor	at				\$
Compensation Ins. at \$ 1.13 per C.					\$ 2.37
Trucking					\$ 2.00
Pay't Patch					\$
Tap by Miller					\$
					\$
					\$
O'head					\$
					\$ 32.47

69

St. _____
Pl. _____
Ave. No. 10

Fulton
Name of Owner _____
Telfair

Labor and Mat'l. Report June 27 1949

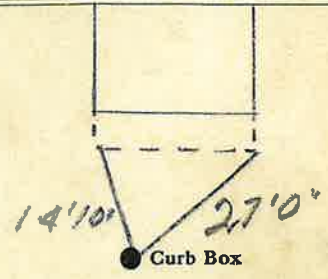

10 Main Elev. of Main at tap 5
Gate at ● Gate at ●

● Curb Box

LSM-5C B 15-48 To be billed ✓