

### LABOR AND MATERIALS

1	Copper Lead	Connection	3/4	\$ 2.87
1	Curb	Cock Valve	3/4 in.	\$ 3.62
		T. S. & V.		
1	Service box	Short 3/2 X 4 1/2		4.68
	Old returned	Long 4 1/2 X 5 1/2		
		Buff or Rdway		
12	Ft. 3/4 in.	Copper Pipe at	32	\$ 3.84
		G. I.		
		C. I.		
	Nipples	in. at		\$
	Bushings	to in. at		\$
	Red'g			\$
	Inc'g	Coupl'gs. to in. at		\$
	Union	in. at		\$
	Meter	in. at		\$
	Lead Joints	at		\$
	Compound Joints	at		\$
3	Hrs. Water Maint. Man-1	at	1.17	\$ 3.36
3	Hrs. Water Maint. Man-2	at	1.02	\$ 3.06
7	Hrs. Labor-	at	91	\$ 4.57
	Hrs. Labor-	at		\$
	Hrs. Compressor	at		\$
	Compensation Ins.	at \$ 7.18 per C.		\$ 0.78
	Trucking			\$ 2.00
	Pav't Patch			\$
	Tap by Miller			\$
	O'head			\$
				\$ 30.08


71

St. Fulton  
~~Pl.~~  
 Ave. No. 12

Name of Owner

Foley

Labor and Mat'l. Report June 27 1944

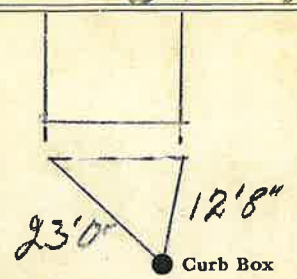

10 Main

Elev. of Main at tap 5

Gate at ●

● Gate at

● Curb Box

*To be Billied*

